


T. 1S. R. 3W. W.M.

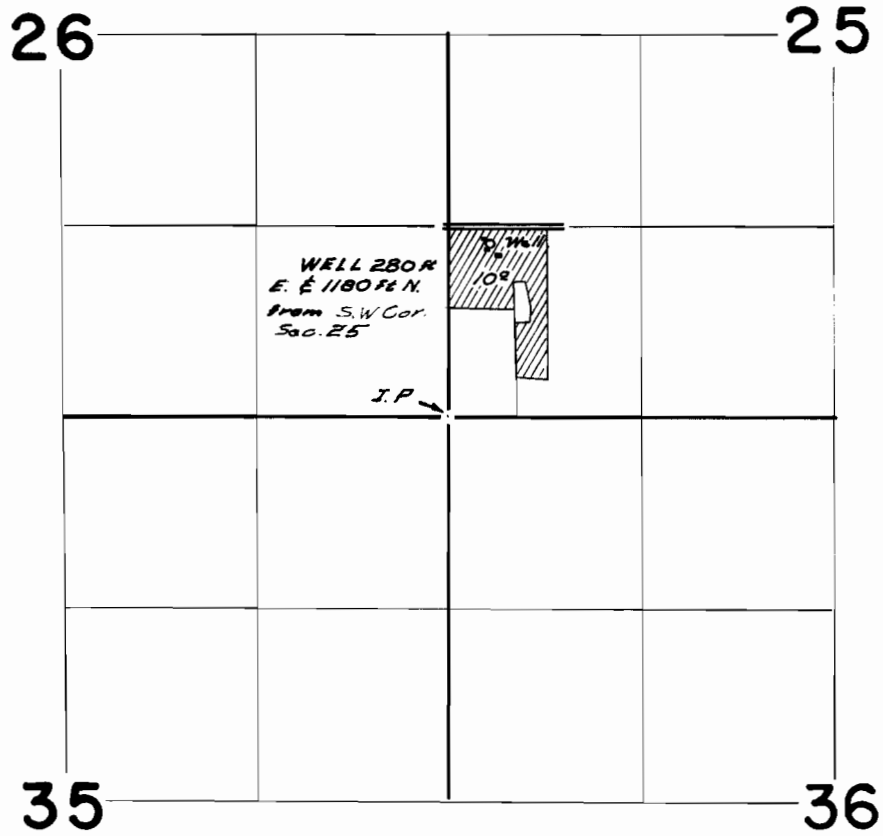

FINAL PROOF SURVEY
UNDER

Application No. G-2449 Permit No. G-2249
IN NAME OF

Arthur B. Curtis

Surveyed Aug 26, 1966, by W.D. Ruppert