


T. 1 N. R. 3 W. W. M.

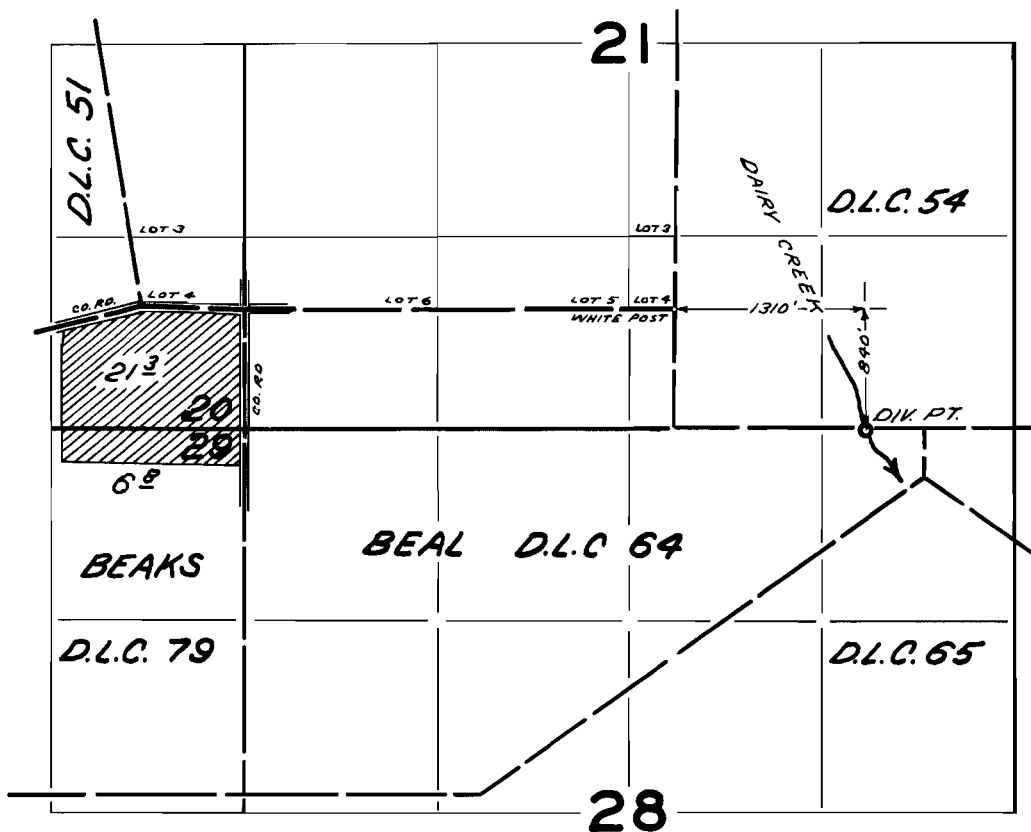

FINAL PROOF SURVEY
UNDER

Application No. 38707 Permit No. 28823
IN NAME OF

WALTER J. LEPSCHAT

Surveyed APR 4 1967, by W. J. RUPPERT