


T.1&2N.R.4W.W.M.

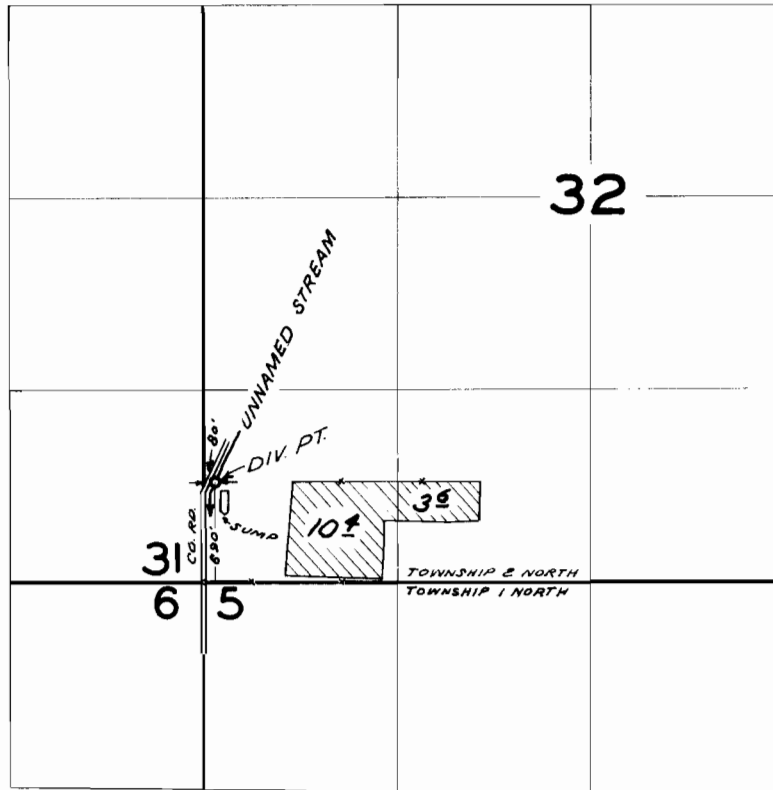

FINAL PROOF SURVEY  
UNDER

Application No. 39118 Permit No. 29118  
IN NAME OF

*RUSSELL OBERG*

Surveyed *MAY 10* 1967, by *V. GARNER*