


# T. 1 N. R. 4 W. W. M.

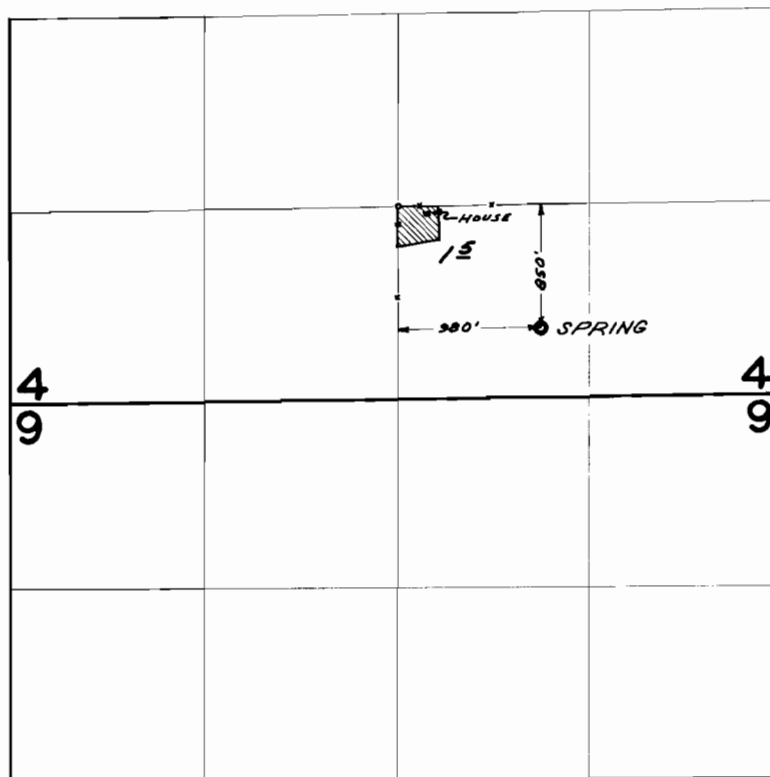

## FINAL PROOF SURVEY UNDER

Application No. 41394 Permit No. 30920  
IN NAME OF

R. B. McMINN

Surveyed MAY 9 1967, by V. GARNER