


T. 1 S. R. 2 W. W. M.

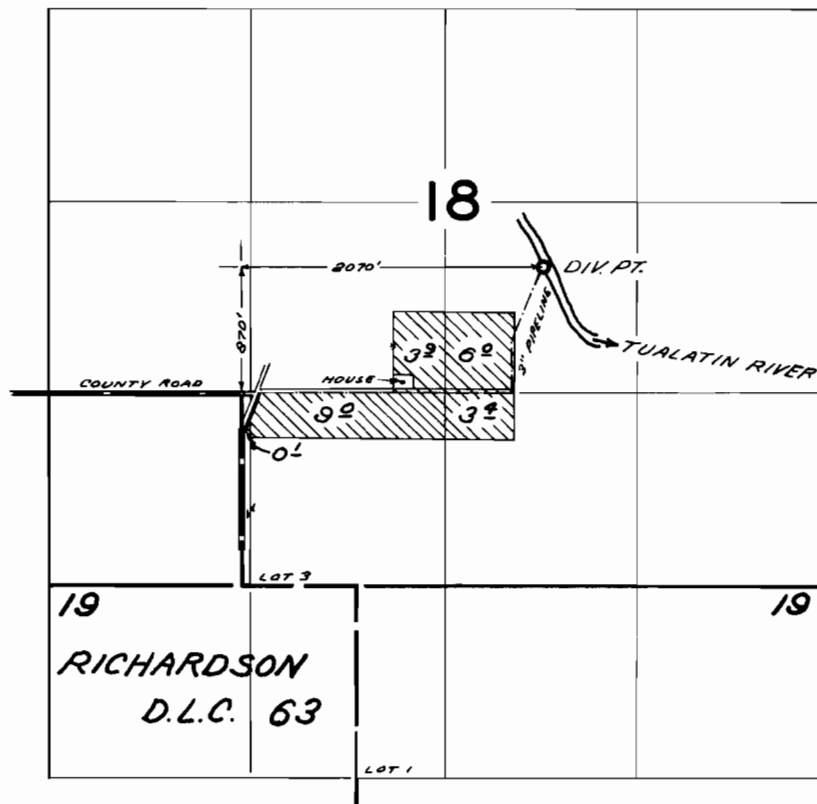

FINAL PROOF SURVEY
UNDER

Application No. 41689 Permit No. 31100
IN NAME OF

ERNEST L. HINES

Surveyed AUG 16 1967, by W. J. RUPPERT