


T.1N.R.4W.W.M.

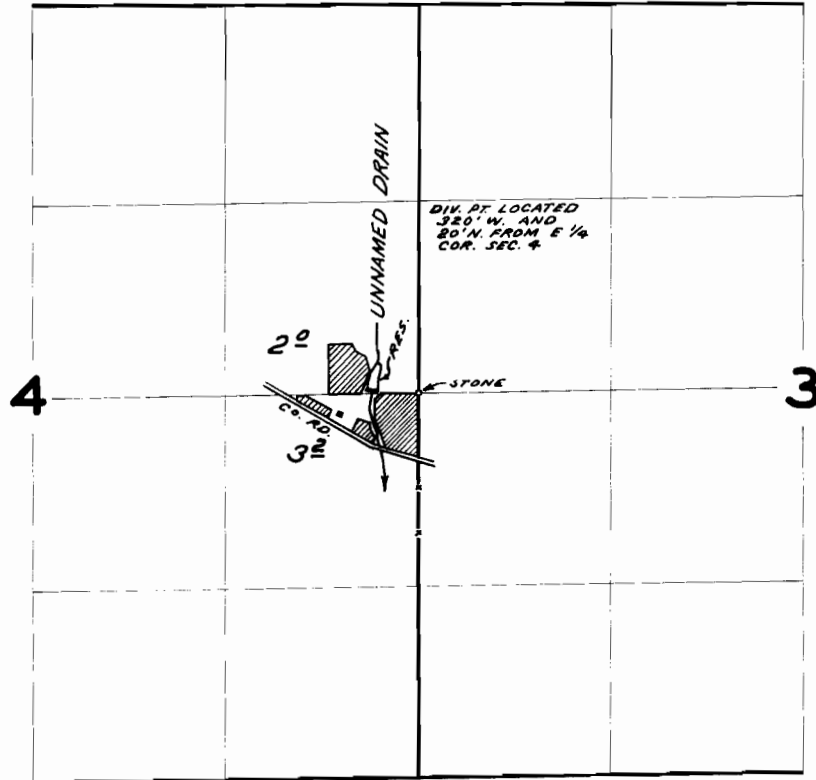

FINAL PROOF SURVEY UNDER

Application No. R-41886 41887 Permit No. R-4768 31352
IN NAME OF

JAMES A. SAYER

Surveyed MAY 10 1967, by V. GARNER