


# T. I S. R. 3 W. W. M.

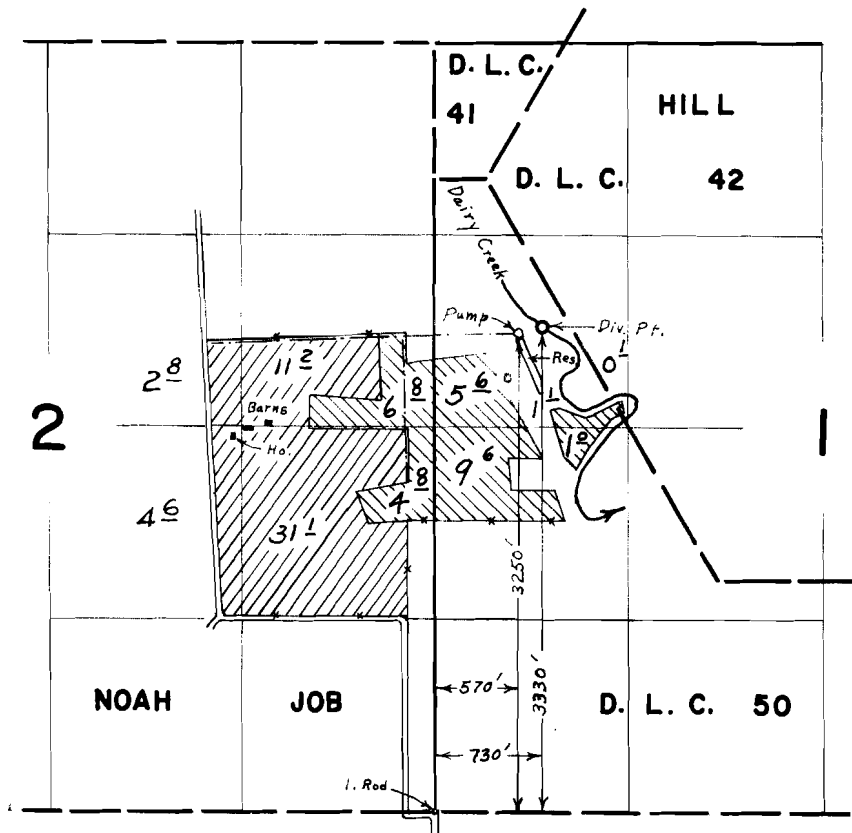

## FINAL PROOF SURVEY UNDER

Application No. R-41992 41993 Permit No. R-4809 31708

IN NAME OF

**GERALD VAN DYKE**

Surveyed Sept. 11, 1967, by L. E. Gould