


T. I S. R. 3 W. W. M.

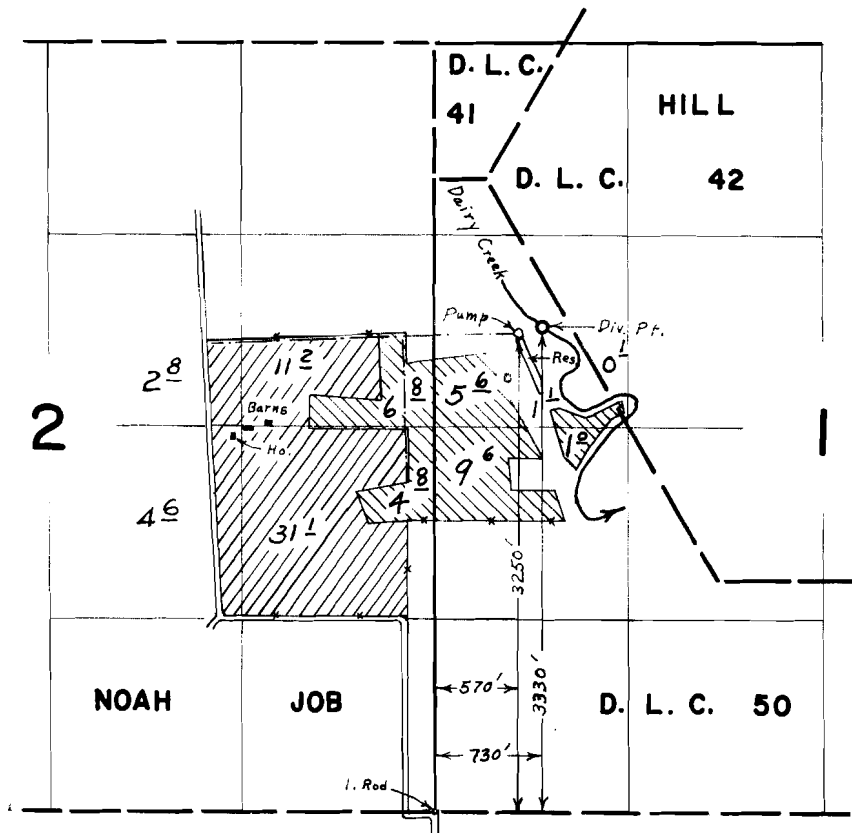

FINAL PROOF SURVEY UNDER

Application No. *R-41992* ~~41993~~ Permit No. *R-4809* ~~31708~~

IN NAME OF

GERALD VAN DYKE

Surveyed *Sept. 11, 1967*, by *L. E. Gould*