


T.2S. R.3W. W.M.

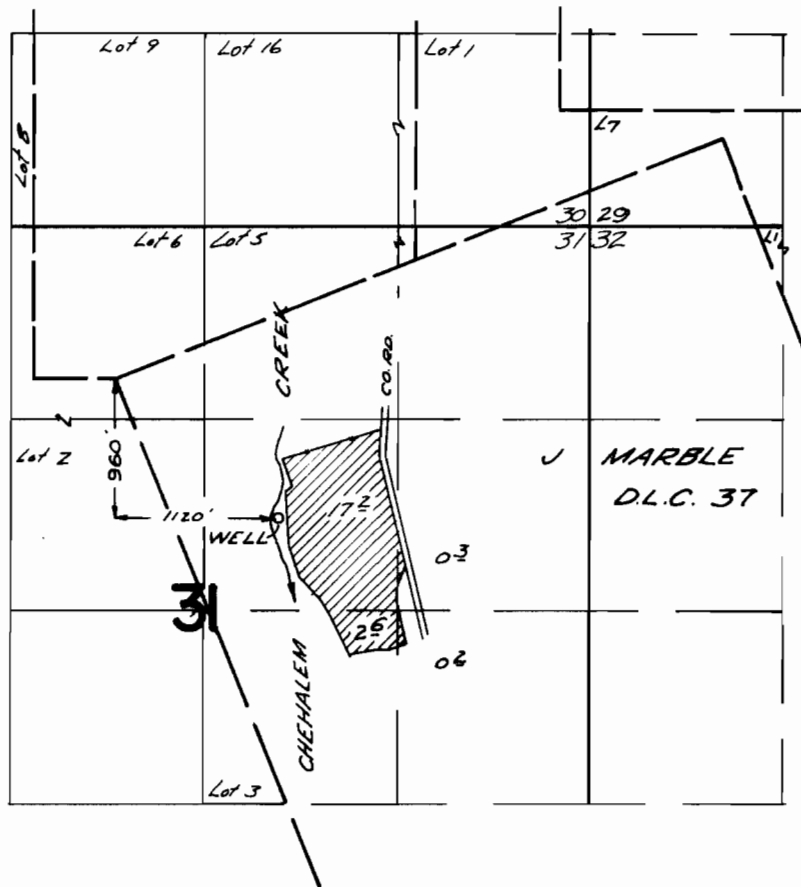

FINAL PROOF SURVEY UNDER

Application No. G-1477 Permit No. G-168
IN NAME OF

E. W. LEFFLER

Surveyed Sept. 7, 1967, by V. Garner