


T. 4 S. R. 4 W. W.M.

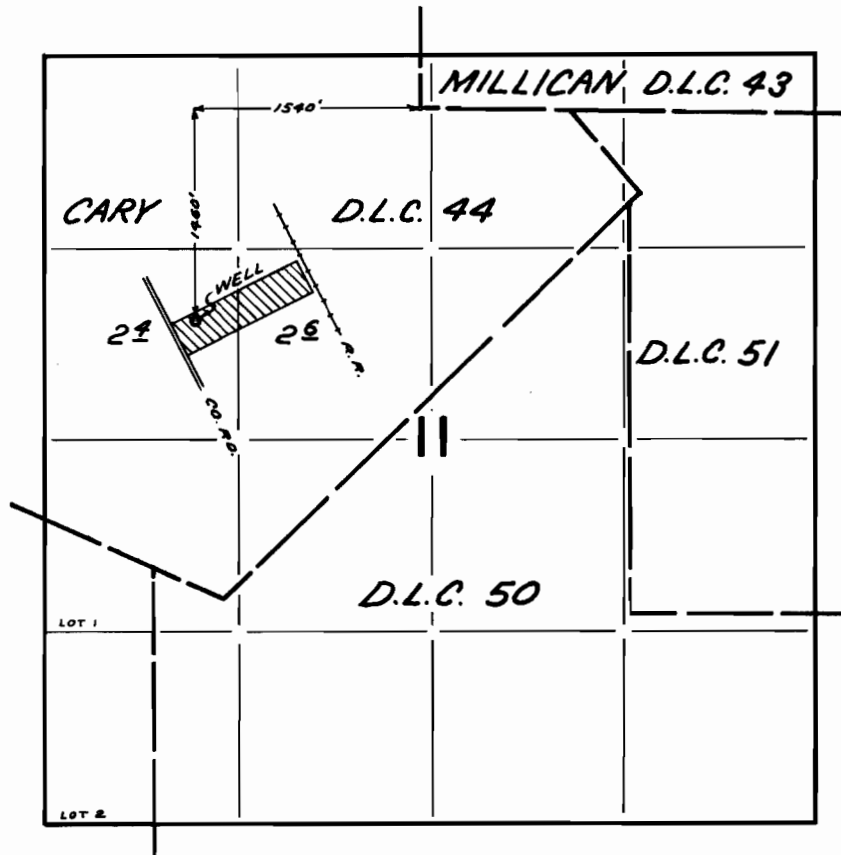

**FINAL PROOF SURVEY**  
UNDER

Application No. G-3205 Permit No. G-2998  
IN NAME OF

MATT VAN LAANEN

Surveyed MAY 4 1967, by V. GARNER