


T. 4S. R. 3 W. W.M.

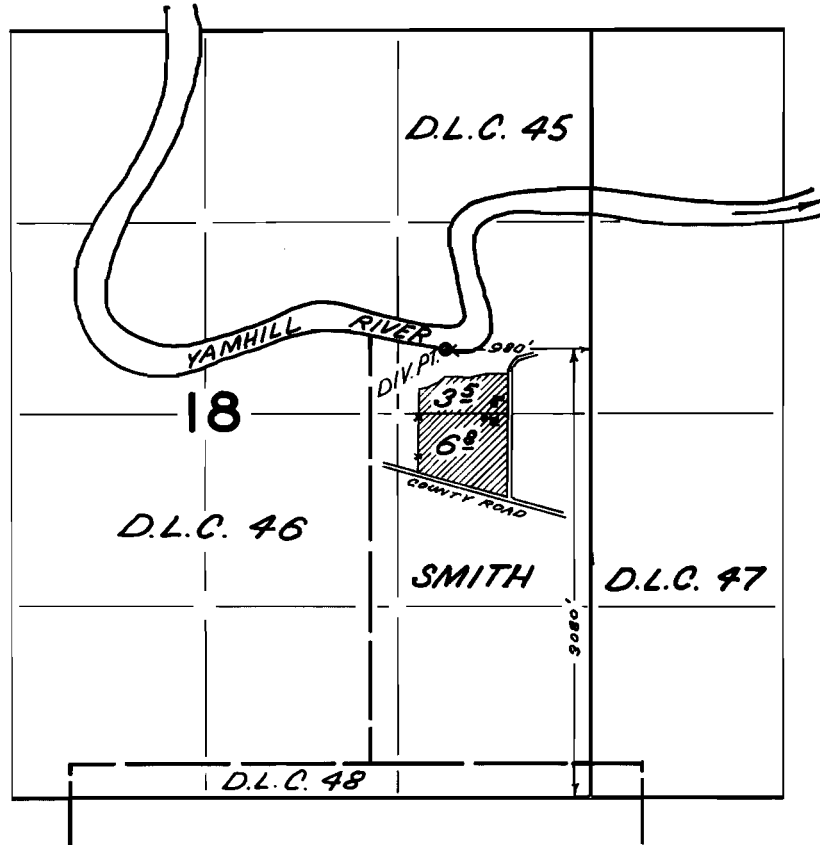

**FINAL PROOF SURVEY**  
UNDER

Application No. 38319 Permit No. 38528  
IN NAME OF

GEORGE E. & MARY E. CRAM

Surveyed MAY 5 1967, by V. GARNER