


T. 4 S. R. 3 W. W. M.

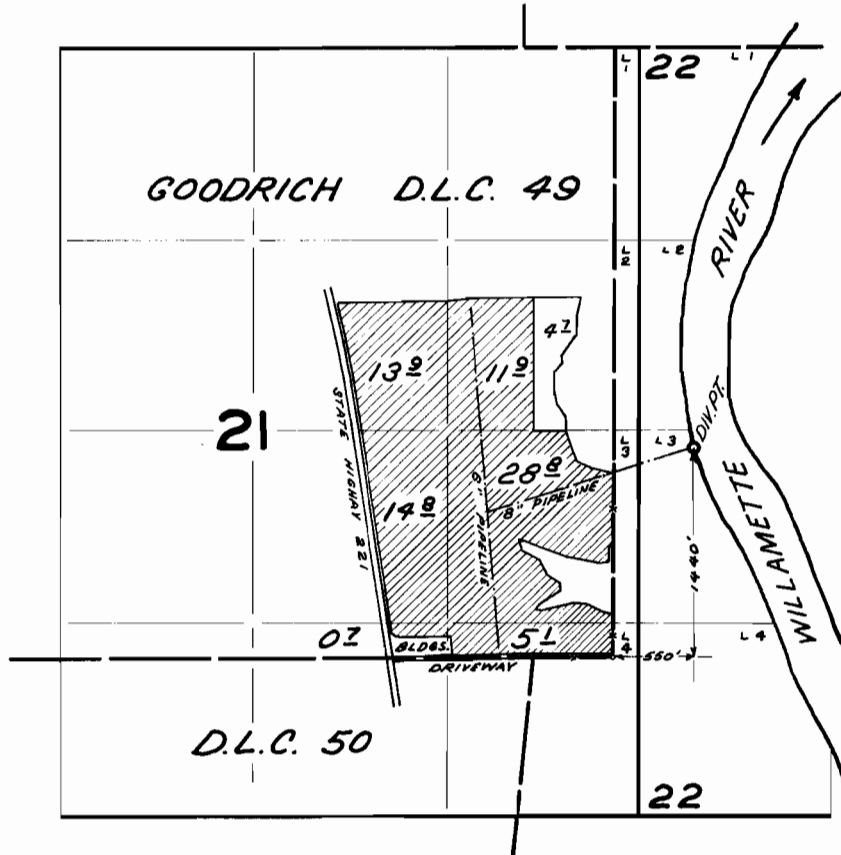

FINAL PROOF SURVEY
UNDER

Application No. 38418 Permit No. 28613
IN NAME OF

BARRY HOUSE

Surveyed MAY 31 1967, by V. GARNER