


T. 4 S. R. 5 W. W.M.

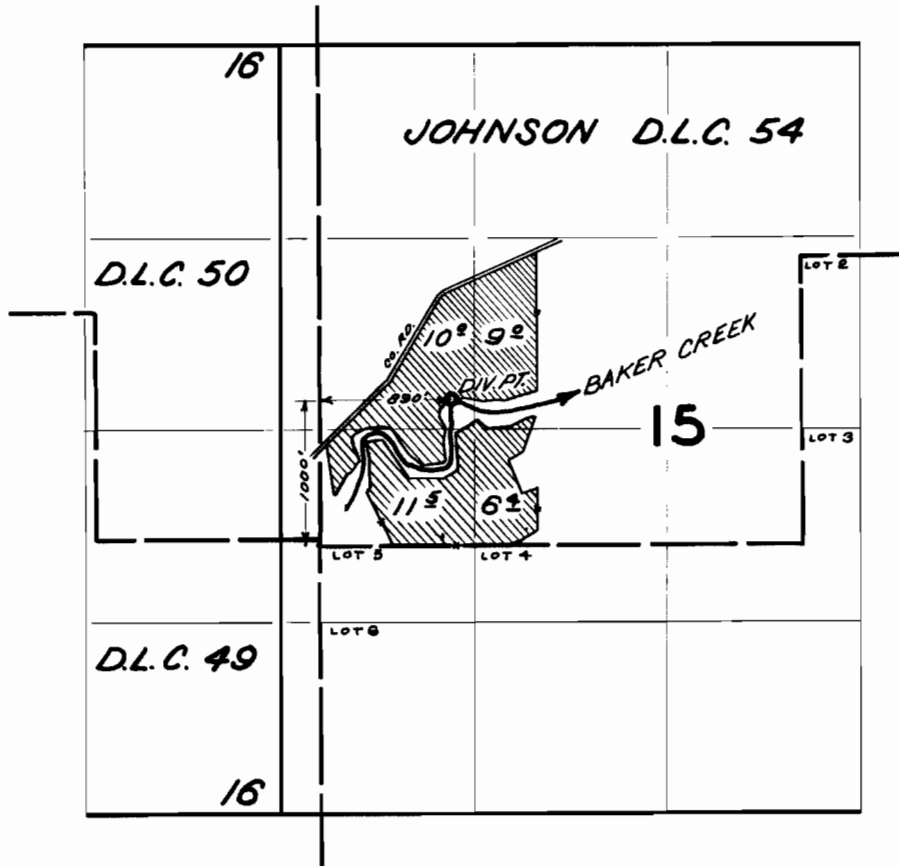

**FINAL PROOF SURVEY**  
UNDER

Application No. 39175 Permit No. 29157  
IN NAME OF

FRED R. FLORY

Surveyed MAY 3 1967, by V. GARNER