


# T.6S. R.39E. W.M.

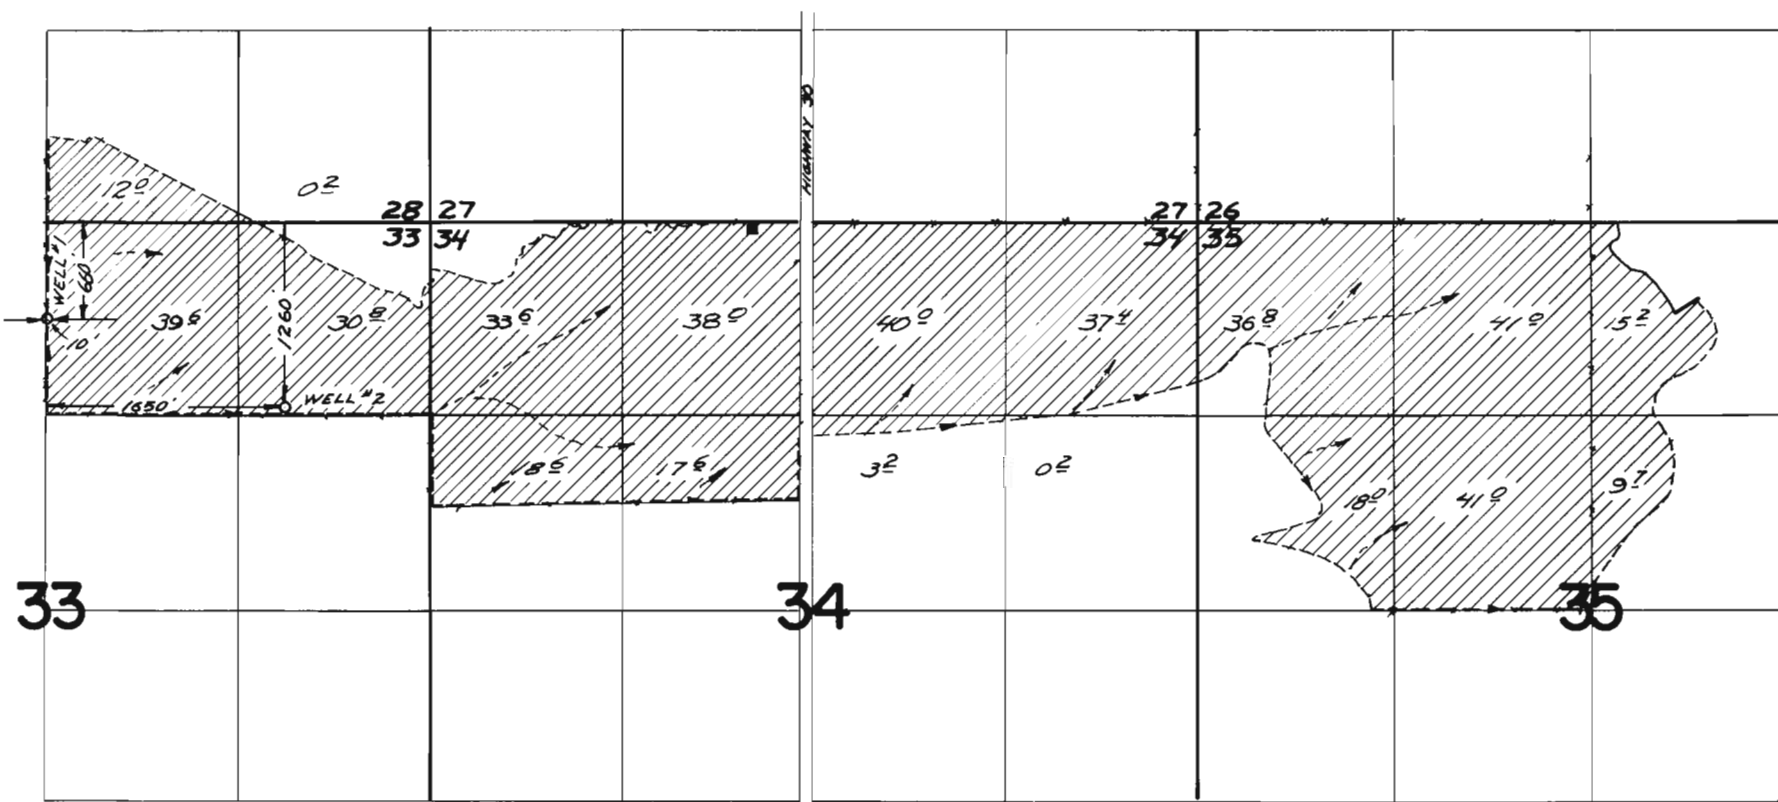

## FINAL PROOF SURVEY

UNDER

Application No. G 2861      Permit No. G 2662

IN NAME OF

**R. D. RASMUSSEN**

Surveyed October 31, 1967 by V. R. Garner