


# T.4S.R.4E.W.M.

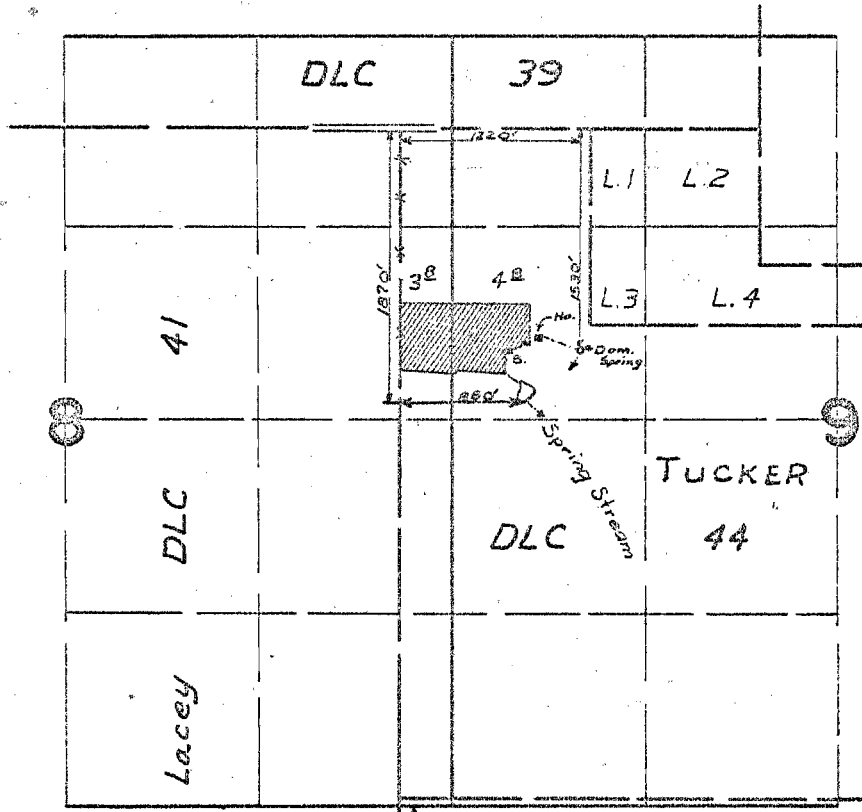

## FINAL PROOF SURVEY UNDER

Application No. R-37823 Permit No. R-3087  
37824 28203  
 IN NAME OF

Royal V. Praudfit

Surveyed Sept. 8, 1967, by W.J. Ruppert