


T.4S.R.4E.W.M.

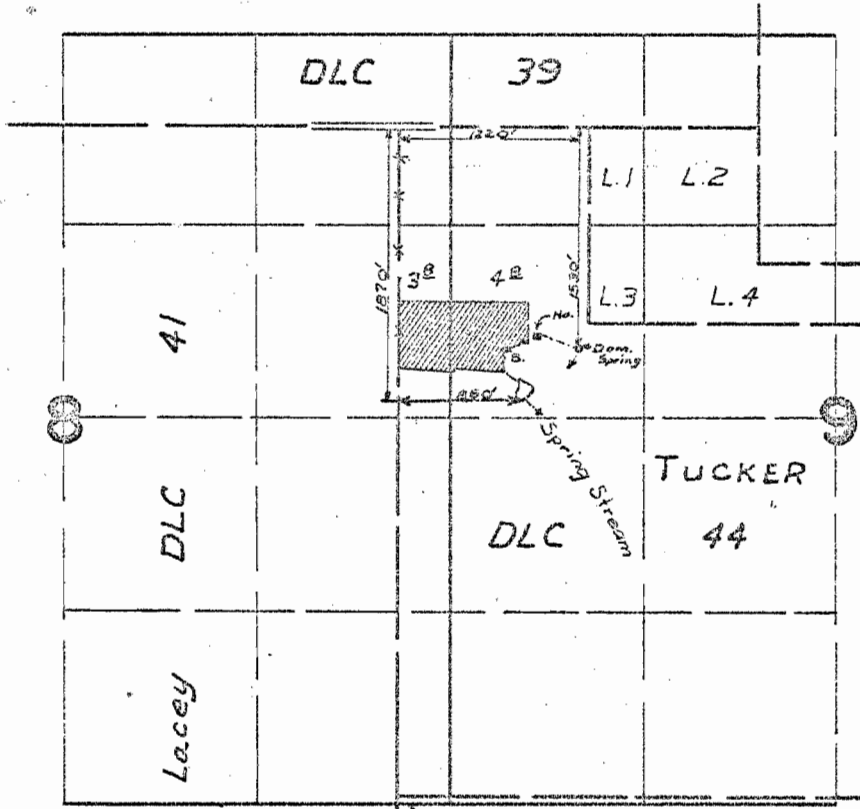

FINAL PROOF SURVEY UNDER

Application No. *R-37823* Permit No. *R-3087*
37824 *28203*
 IN NAME OF

Royal V. Praudfit

Surveyed *Sept. 8, 1967*, by *W.J. Ruppert*