


T.3S.R.3E.W.M.

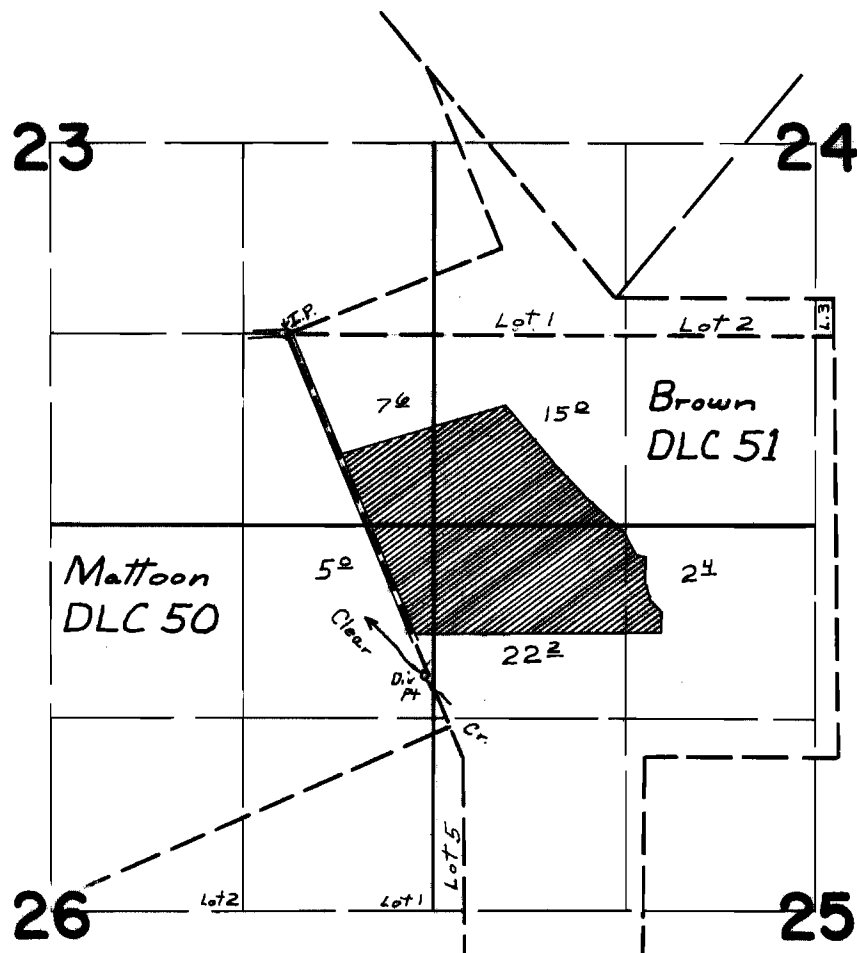

Div Pt located 2340ft S. & 950ft E from NW Cor Jas. Brown
DLC 51, being within NE $\frac{1}{4}$ NE $\frac{1}{4}$ Sec 26

FINAL PROOF SURVEY
UNDER

Application No. 38841 Permit No. 28894
IN NAME OF

Clarence Jubb

Surveyed June 2, 1967, by W.J. Ruppert