T. 2 S. R. 2 E. W.M.

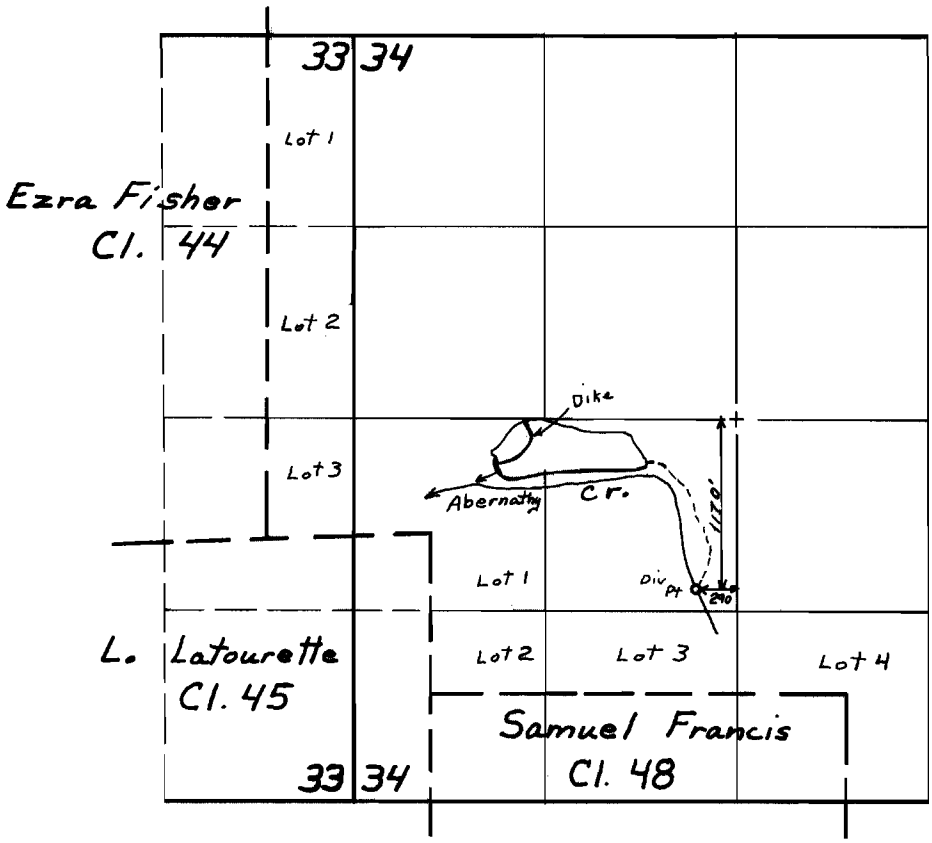

FINAL PROOF SURVEY
UNDER

Application No. R-39837 39838 Permit No. R-4776 31401

IN NAME OF

Clarence A. Hitchman

Surveyed June 2 July 5 19 67, by W. J. Ruppert

1967L GRD