


T.2S.R.2E.W.M.

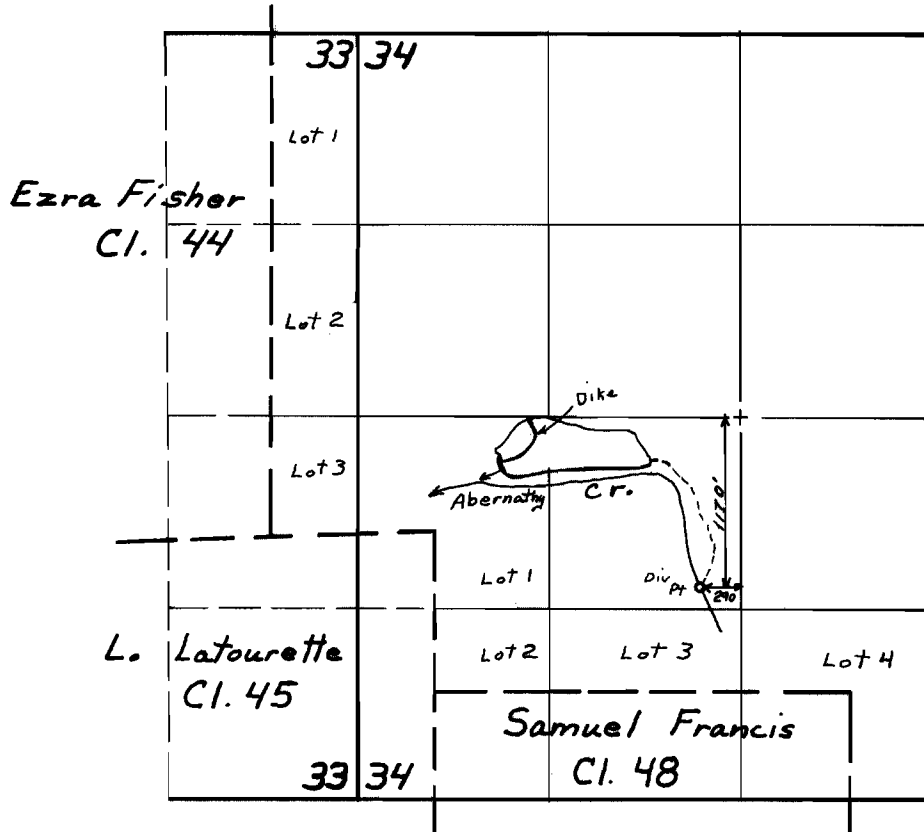

FINAL PROOF SURVEY UNDER

Application No. 39838 ^{R-39837} Permit No. 31401 ^{R-4776}
 IN NAME OF

Clarence A. Hitchman

Surveyed June 2
July 5 1967, by W. d. Ruggert