


T.4S.R.3E.W.M.

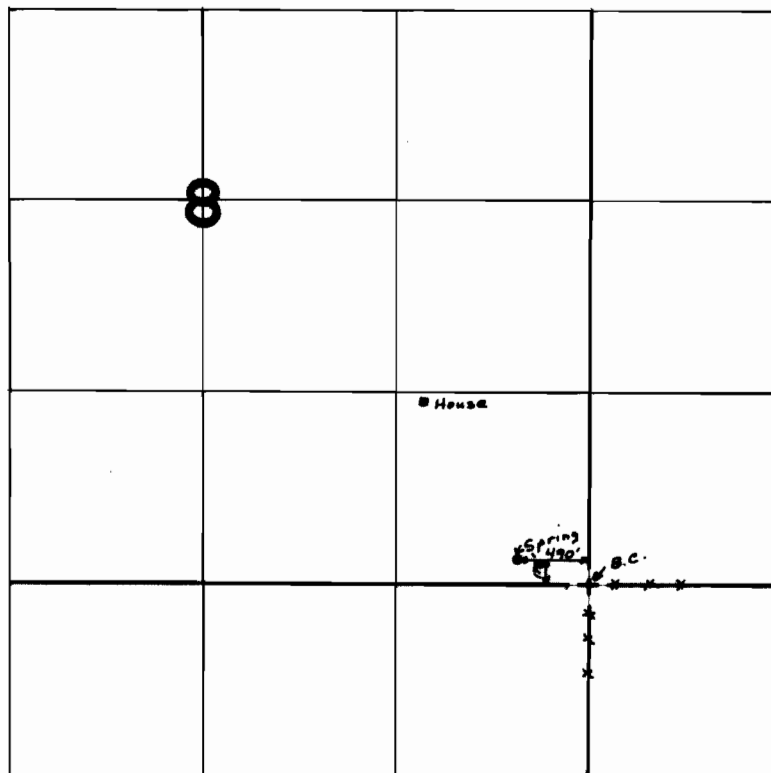

FINAL PROOF SURVEY
UNDER

Application No. 42652... Permit No. 31878...
IN NAME OF

.....*Russell B. Wilson*.....

Surveyed June 1..... 1967, by *W. J. Ruppert*.....