


T.37 S. R.14 W. W. M.

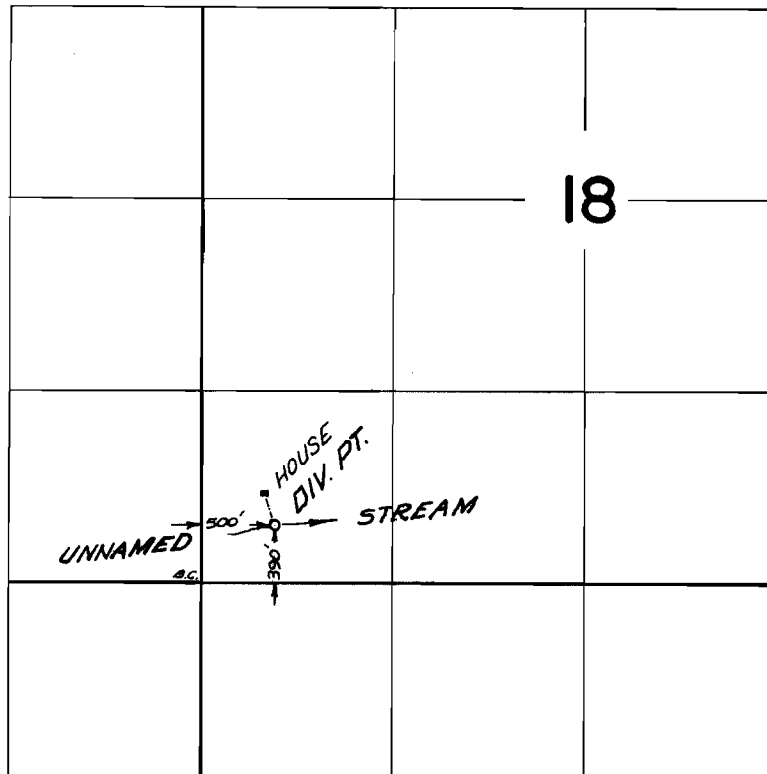

FINAL PROOF SURVEY
UNDER

Application No. 37097 Permit No. 27614
IN NAME OF

ONE STOP BUILDER'S SUPPLY

Surveyed Sept 21 1966, by V. GARNER