T. 28 & 29S. R. 7 W.M.

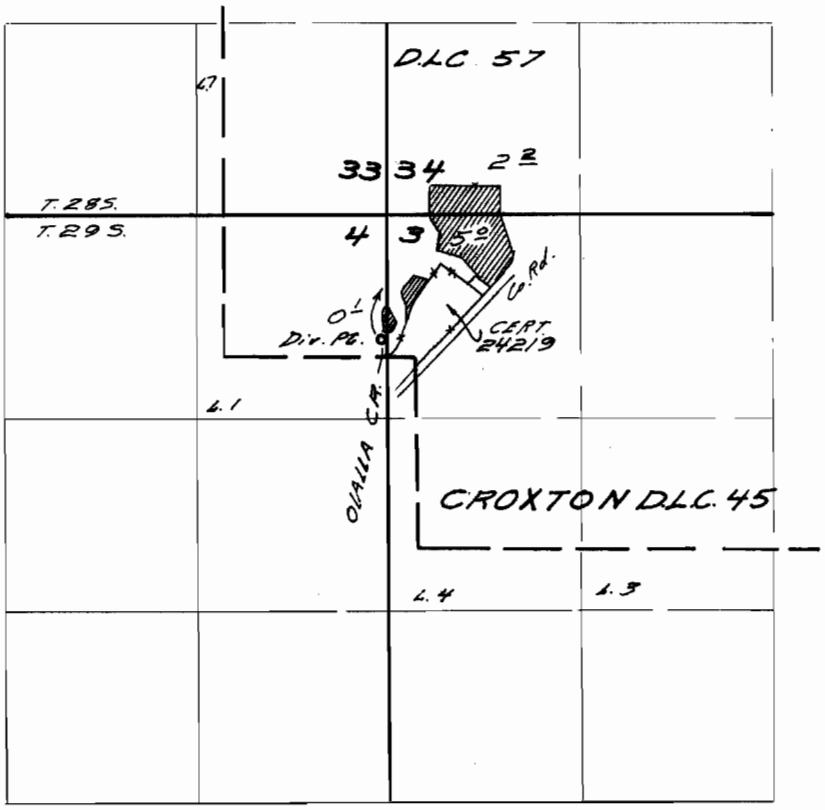

Diversion point located 220 ft. W. & 120 ft. N. from re-entrant corner D.L.C. 45

FINAL PROOF SURVEY
UNDER

Application No. 39721 Permit No. 29551
IN NAME OF

RICHARD J. & ERMA J. WAMBOLT

Surveyed June 6 1967, by W. A. Ruppert

-1967-L