


T.26S. R.5W. W.M.

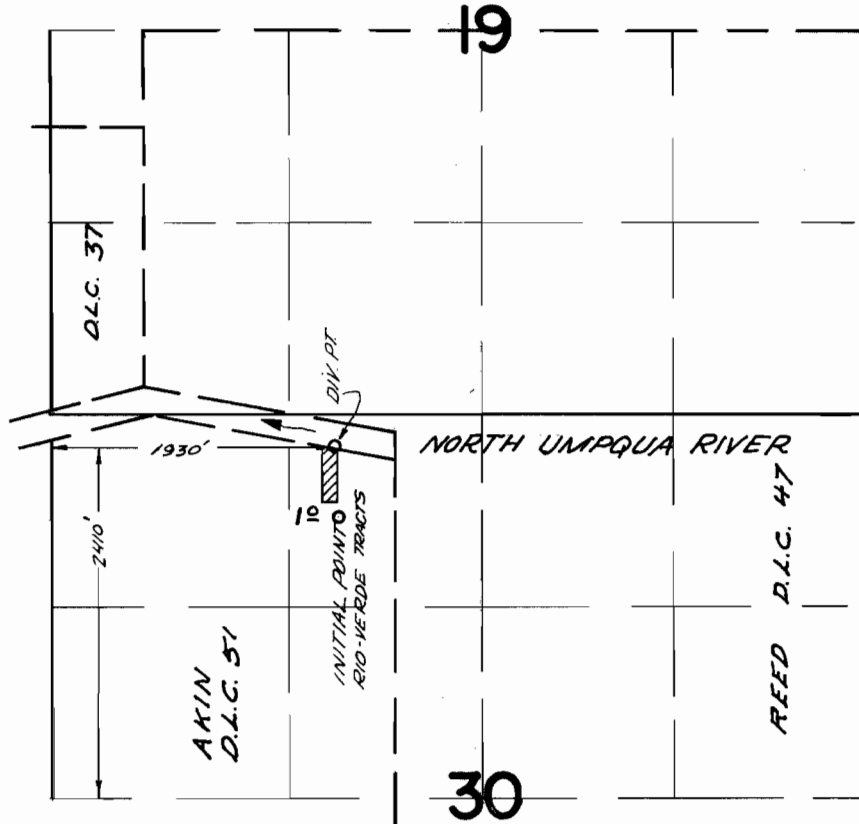

FINAL PROOF SURVEY
UNDER

Application No. 42243 Permit No. 31609
IN NAME OF

Harold R. E., or Ruth M. Smith

Surveyed May 9 1967, by W.V. Ruppert