


PR28563 6

35216

T.13S. R.29E. W.M.

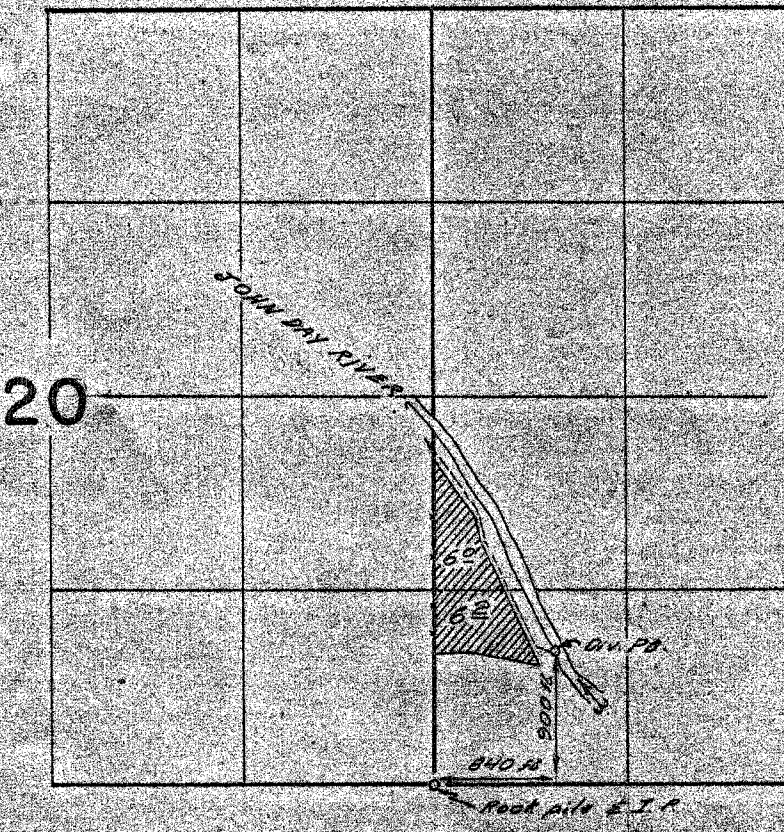

**FINAL PROOF SURVEY**  
UNDER

Application No. 28244 Permit No. 28563  
IN NAME OF

Charles A. Lowrey

Surveyed June 28 1967, by W.D. Piggott