T. 22 S. R. 31 E. W.M.

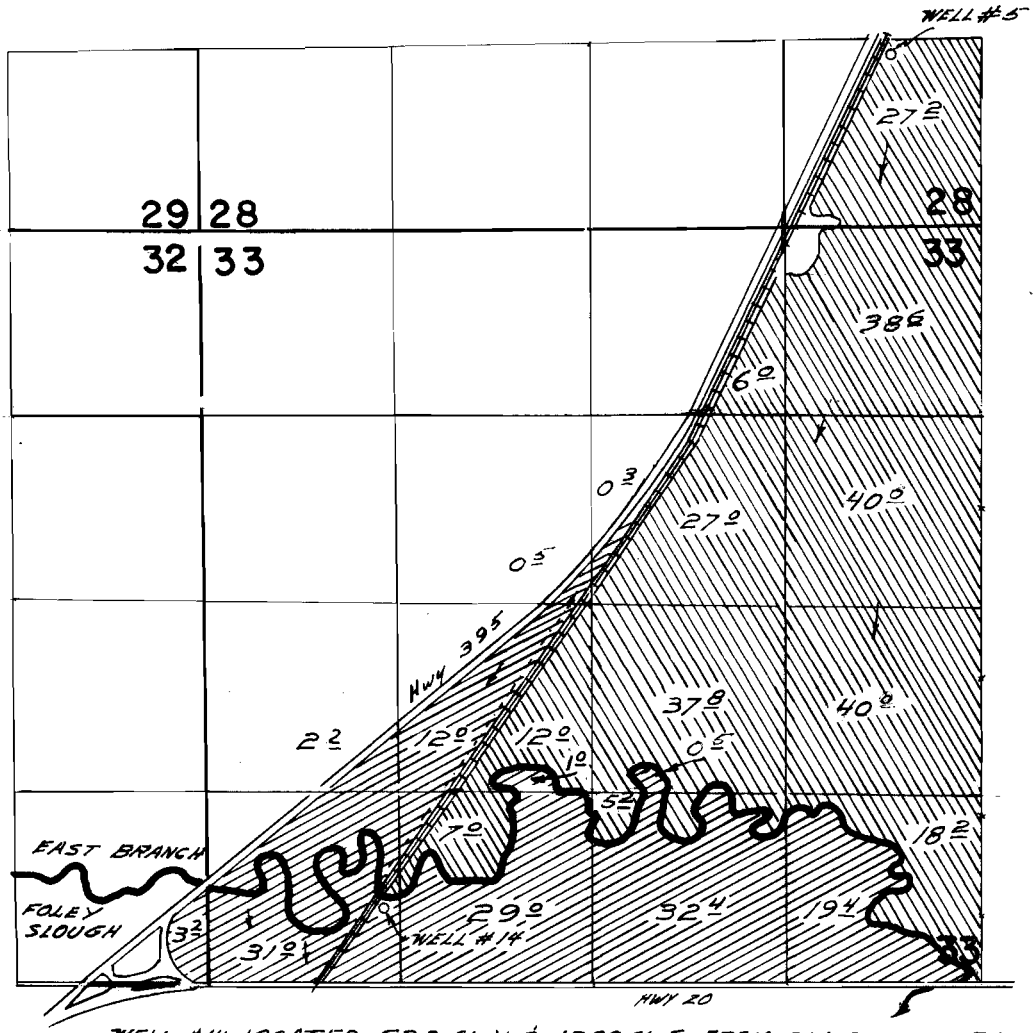

WELL #14 LOCATED 520 ft. N. & 1200 ft. E. FROM S.W. Cor. Sec. 33.
WELL #5 LOCATED 100 ft. S. & 620 ft. W. FROM N.E. Cor. SE1/4 SE1/4 Sec. 28.

IRRIGATED FROM WELL #14

IRRIGATED FROM WELL #5

FINAL PROOF SURVEY
UNDER

Application No. G-1972 Permit No. G-1808
IN NAME OF

Harry Pom

Surveyed Sept. 13 1963, by Carl Baker.
July 28, 1967 V. J. Ryppert.

EF1 - 2V-81
1967-3
W.J.R.