


11/2

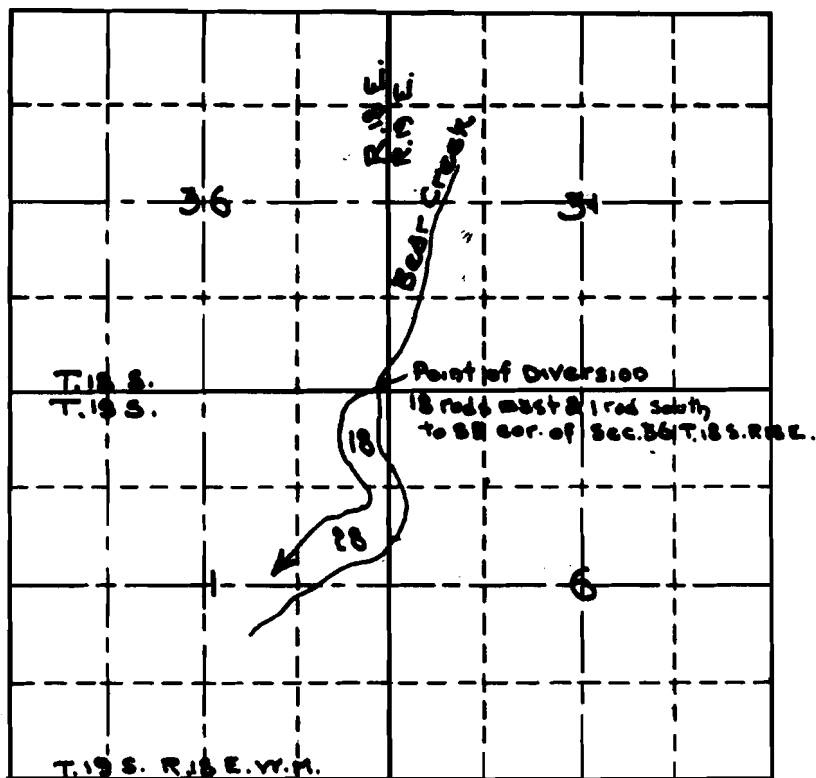

Map
of
J.A. Rickman Ditch

5117
3218

OFFICE OF STATE ENGINEER

NOV 20