


T.35 S.R.1 W.W.M.

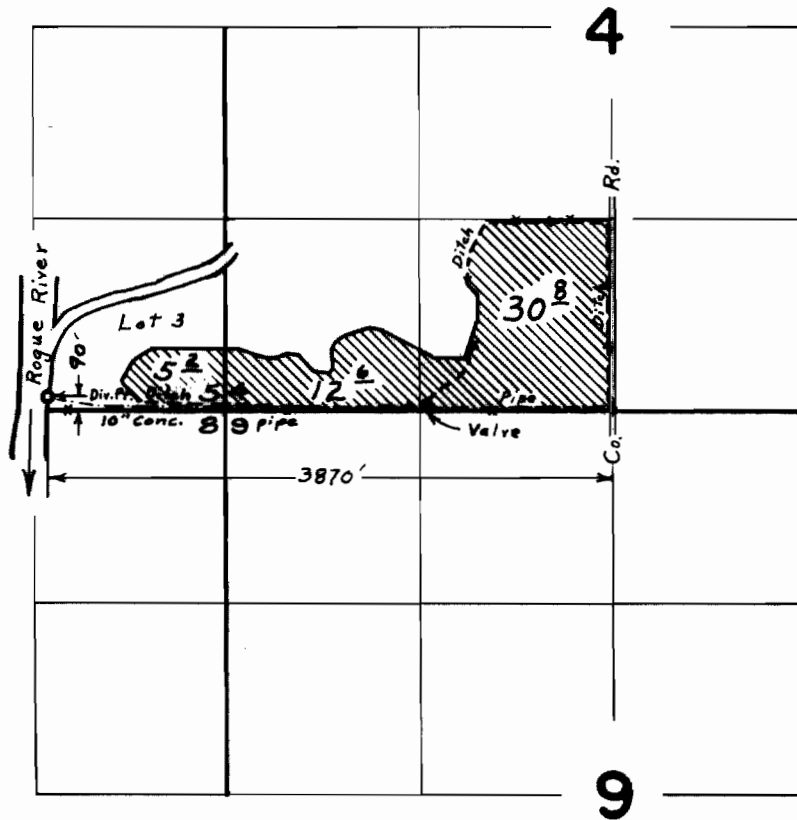

FINAL PROOF SURVEY UNDER

Application No. 34317 Permit No. 26982
IN NAME OF

MERLE E. MCGRAW

Surveyed July 25, 1967, by L. E. Gould