


T.32S.R.1E.W.M.

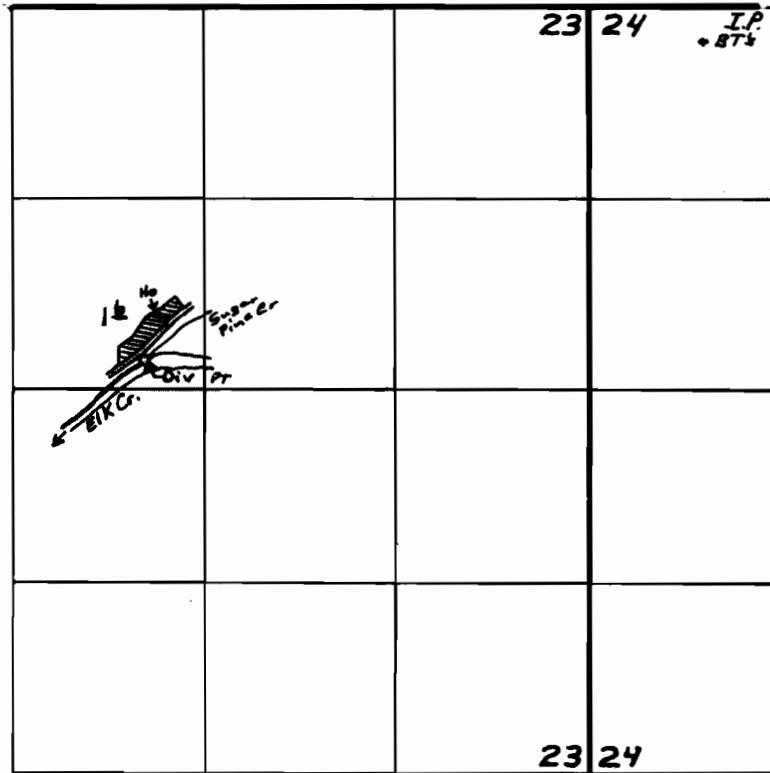

Div Pt located 2430ft S + 4350ft W from NE cor NW 1/4 NW 1/4 of Sec. 24.

FINAL PROOF SURVEY UNDER

Application No. 34938 Permit No. 27405
IN NAME OF

Harold L. Parsher

Surveyed May 19 1967, by W. V. Ruppert