


# T.33 S.R.I W. W.M.

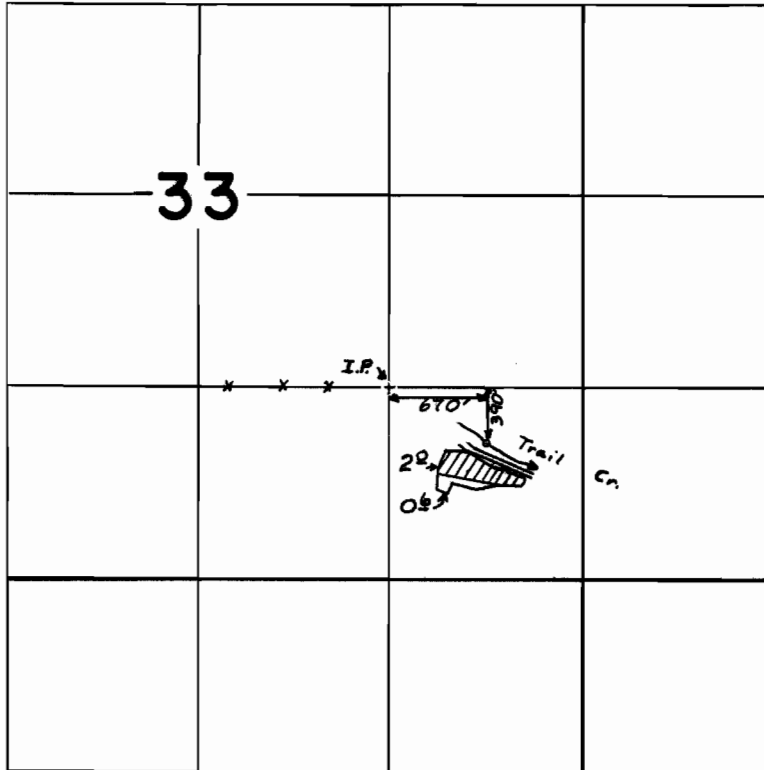

## FINAL PROOF SURVEY UNDER

Application No. 37475 Permit No. 27898  
IN NAME OF

Albert F. Johnson

Surveyed May 17, 1967, by W. d. Ruppert