


# T.34S.R.1W.W.M.

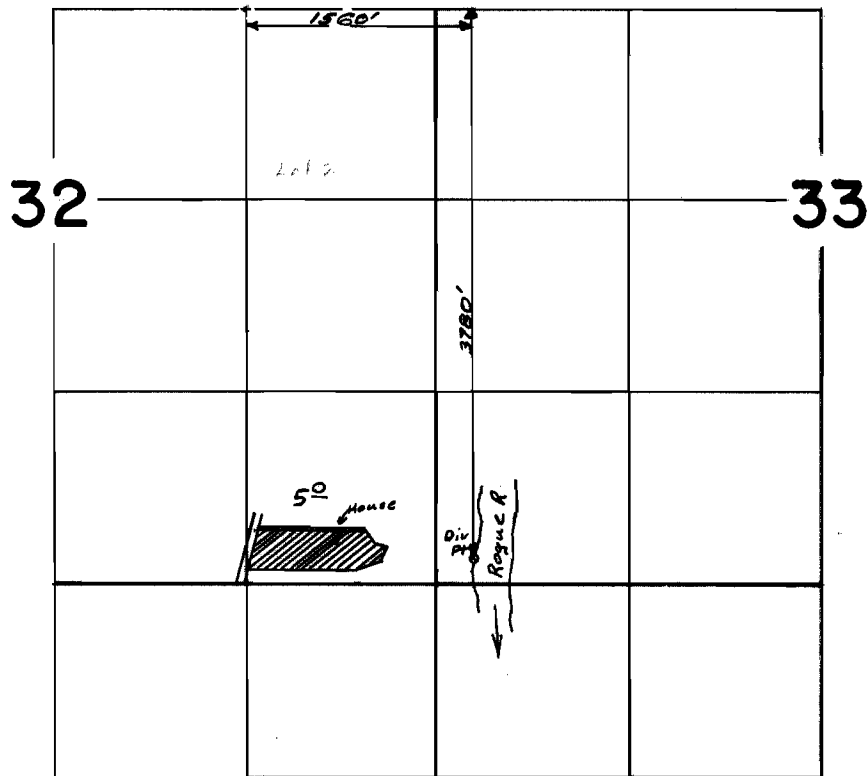

## FINAL PROOF SURVEY UNDER

Application No. 37526 Permit No. 27965  
IN NAME OF

Fred & Gladys Stevenson

Surveyed May 26, 1967, by W. U. Ruppert