
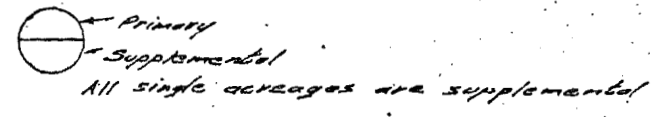


61930 13
35242

T.39 S. R.20 E. W.M.

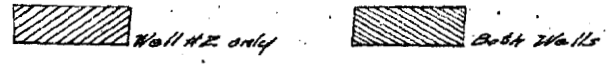

FINAL PROOF SURVEY

UNDER

APPLICATION No. G-2099
G-2182
PERMIT No. G-1930
G-2095

IN NAME OF
FAVELL - UTLEY
REALTY Co., INC.

SURVEYED AUG. 28, 1967
BY W. J. RUPPERT

