


13  
27527  
35245

T. 39 S. R. 19 E. W. M.

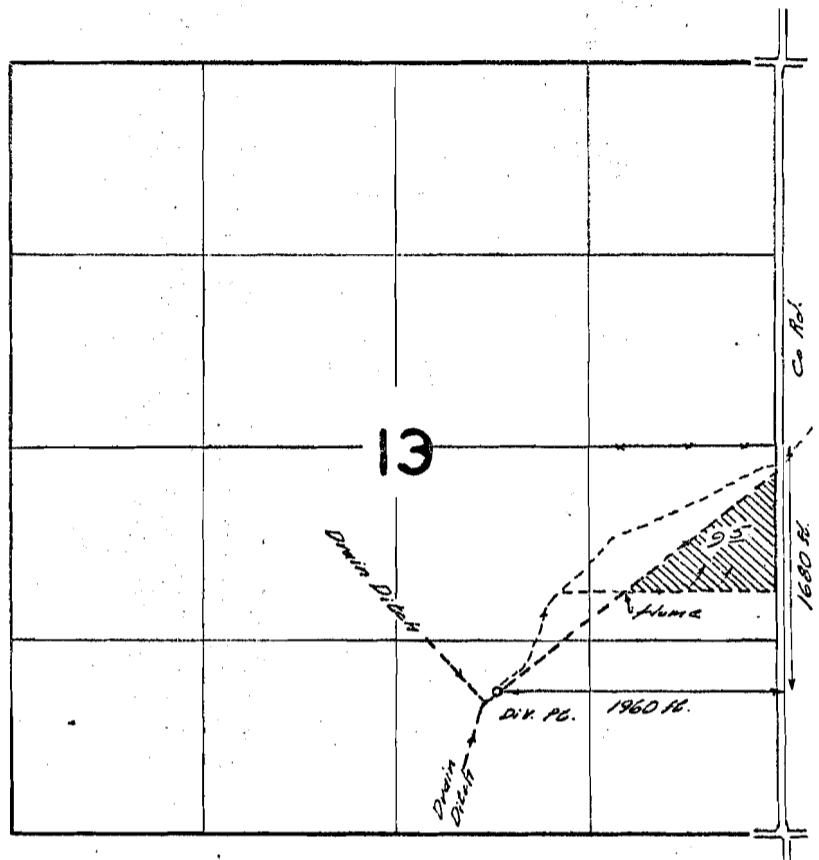

**FINAL PROOF SURVEY**  
UNDER

Application No. 34987 Permit No. 27527  
IN NAME OF

Elmo M. Angele

Surveyed Aug. 23, 1967, by W. D. Ruppert, Jr.

39-196