


27528
3524p

T. 39 S. R. 19 & 20 E. W.M.

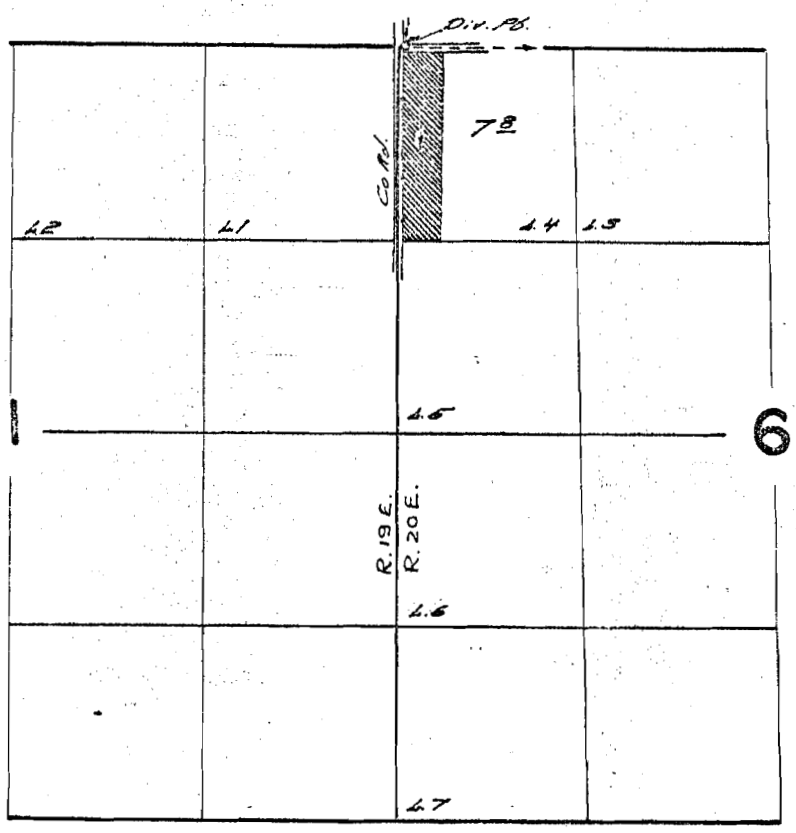

Diversion point located 5 ft. S. & 40 ft. E from NW. Cor. Sec. 6

FINAL PROOF SURVEY UNDER

Application No. 34988 Permit No. 27528
IN NAME OF

Elmo M. Angele

Surveyed Aug. 23, 1967 by W. J. Rupperts

39-1920 ✓