


T.16S.R.3E.W.M.

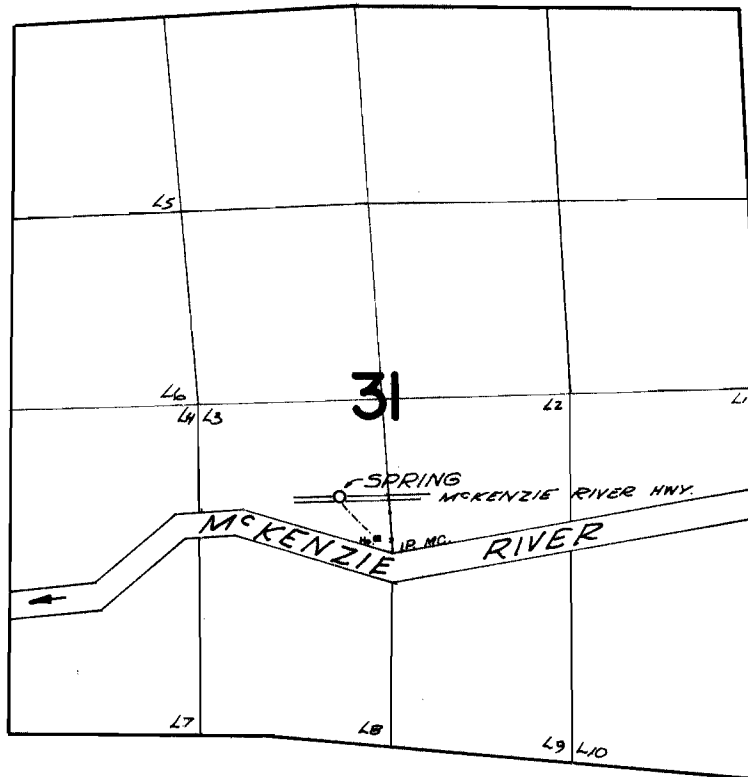

*Spring located 390 ft. N. and 350 ft. W.
from Meander cor. on N.S. line through center Sec.31*

FINAL PROOF SURVEY UNDER

Application No. 33664 Permit No. 26597
IN NAME OF

REYNOLDS S. and ELIZABETH M. ROSS

Surveyed June 15 1967, by V. Garner