


T.15S.R.1W.W.M.

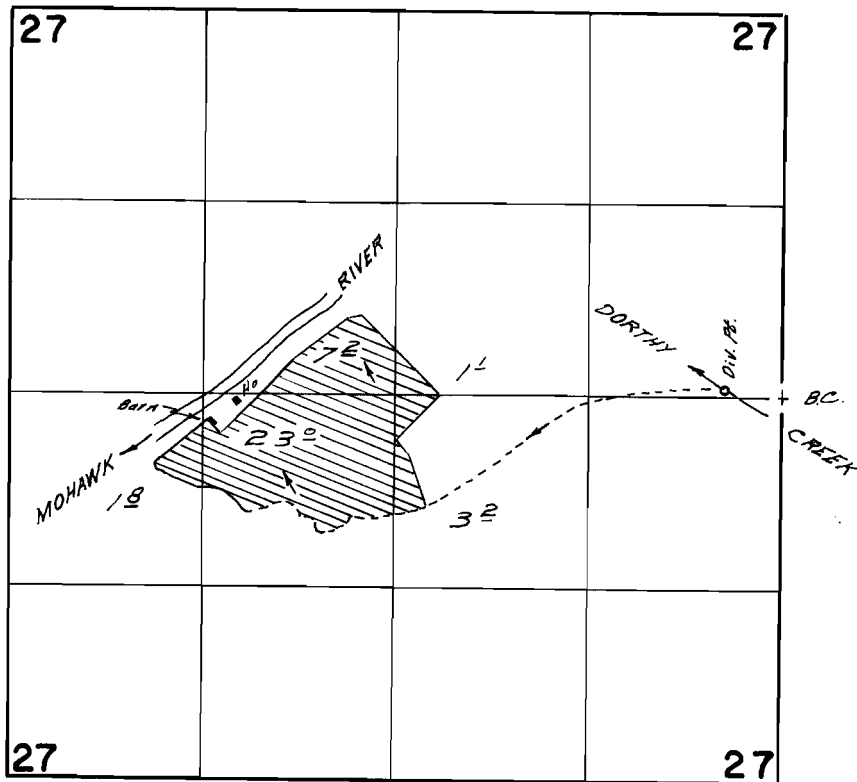

Diversion point located 50 ft. N. & 390 ft. W. from E. 1/4 Corner Section 27.

FINAL PROOF SURVEY UNDER

Application No. 39881 Permit No. 29835
IN NAME OF

Black Hawk Ranch

Surveyed Sept. 14 1967, by Wd. Ruppert