


T. 16 S. R. 2 W. W.M.

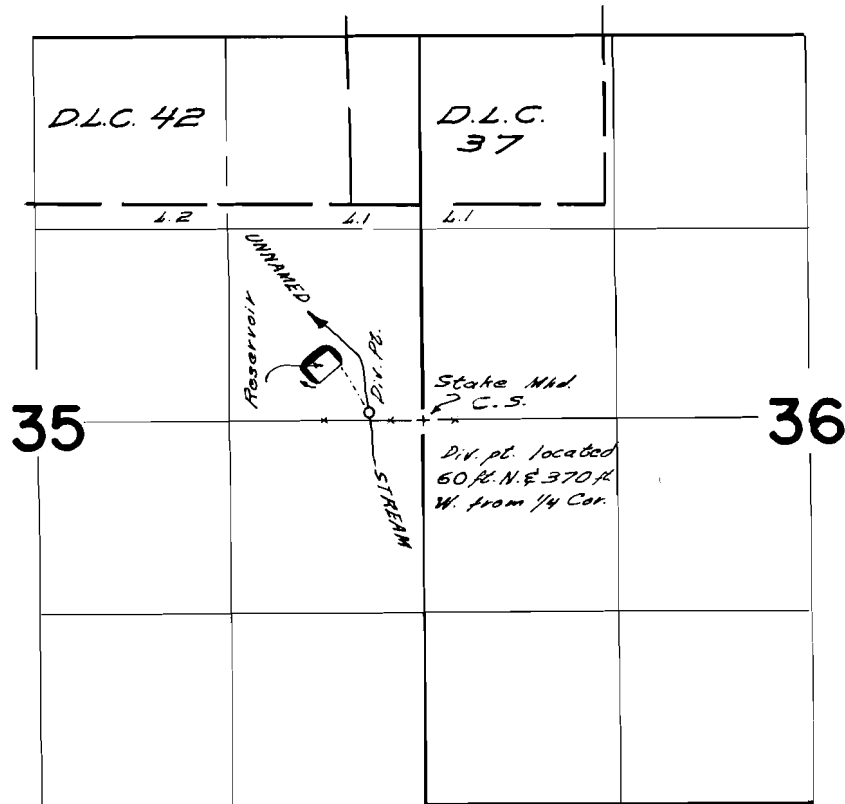

FINAL PROOF SURVEY

UNDER

R-40985

R-4598

40986

30561

Application No. R-41843 Permit No. R-4759

IN NAME OF

Ralph E. LaLone

Surveyed Sept 11, 1967, by W.J. Ruppert