


# T.34 S. R.1 W.W.M.

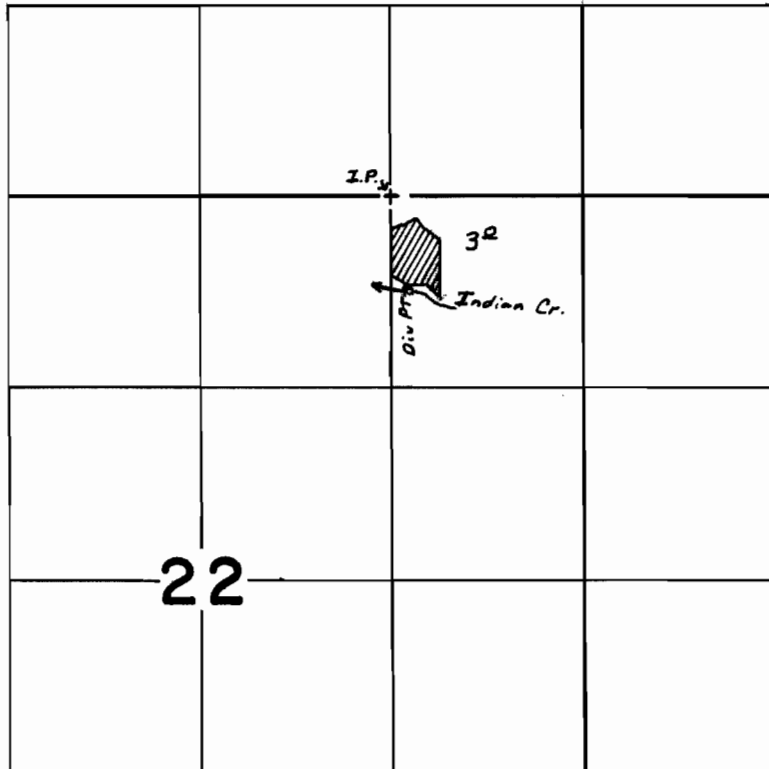

*Div Pt located 650 ft S and 130 ft E from NW Cor of N.E. 1/4 N.E. 1/4*

## FINAL PROOF SURVEY UNDER

Application No. 39876 Permit No. 29690  
IN NAME OF

Olive C. Parks

Surveyed May 16 1967, by W.J. Ruppert