


T.9S.R.3E.W.M.

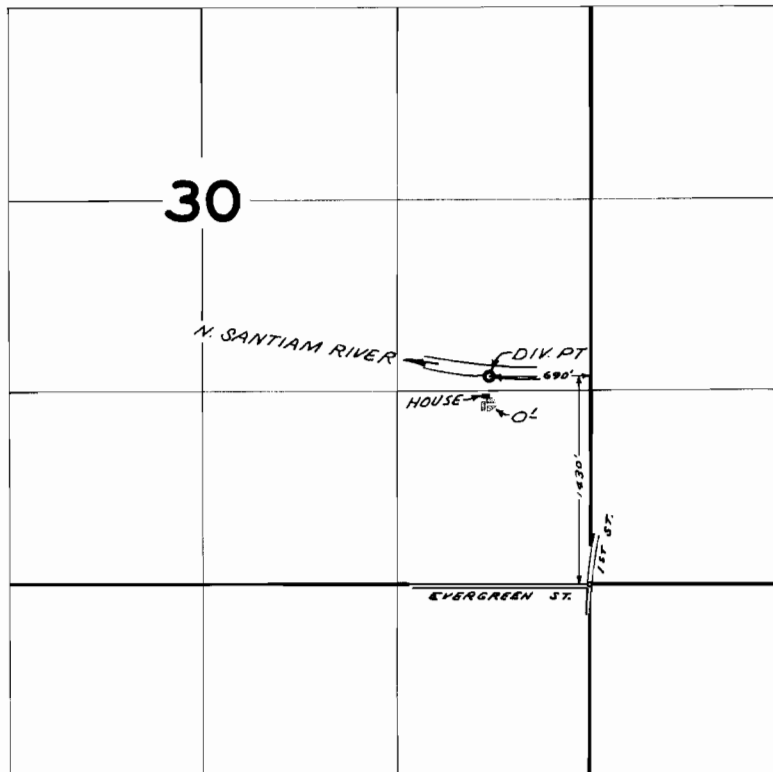

**FINAL PROOF SURVEY**  
UNDER

Application No. 37713 Permit No. 28185  
IN NAME OF

CHARLES C. KELLY

Surveyed MAR. 30 1967, by W. J. RUPPERT