


T.9S.R.3E.W.M.

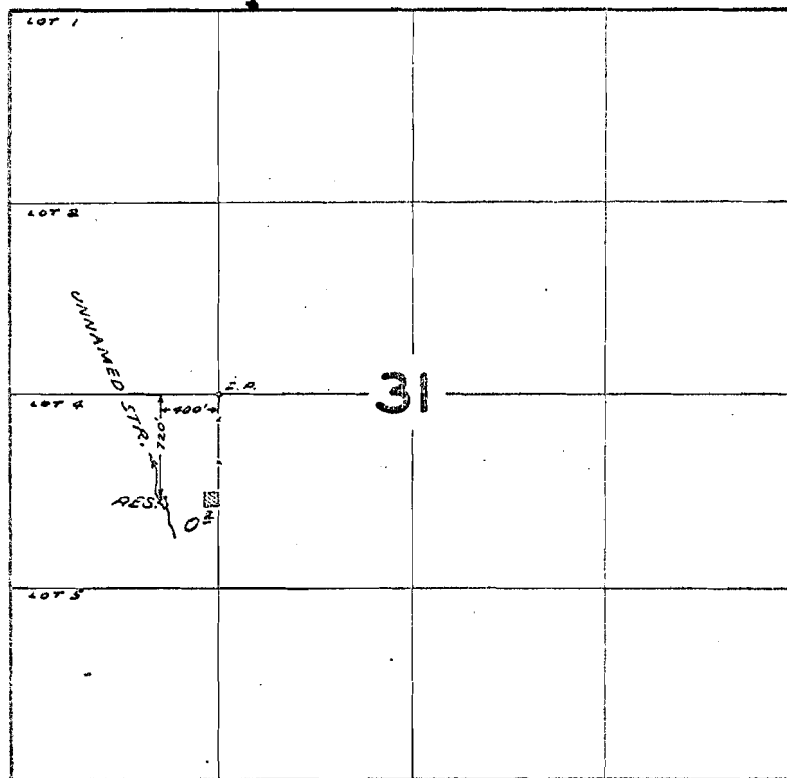

FINAL PROOF SURVEY
UNDER

Application No. R-38214 Permit No. R-3167
IN NAME OF

ARLO C. TUEBS

Surveyed MAR 30 1967, by W. J. RUPPERT