


T.9S.R.1E.W.M.

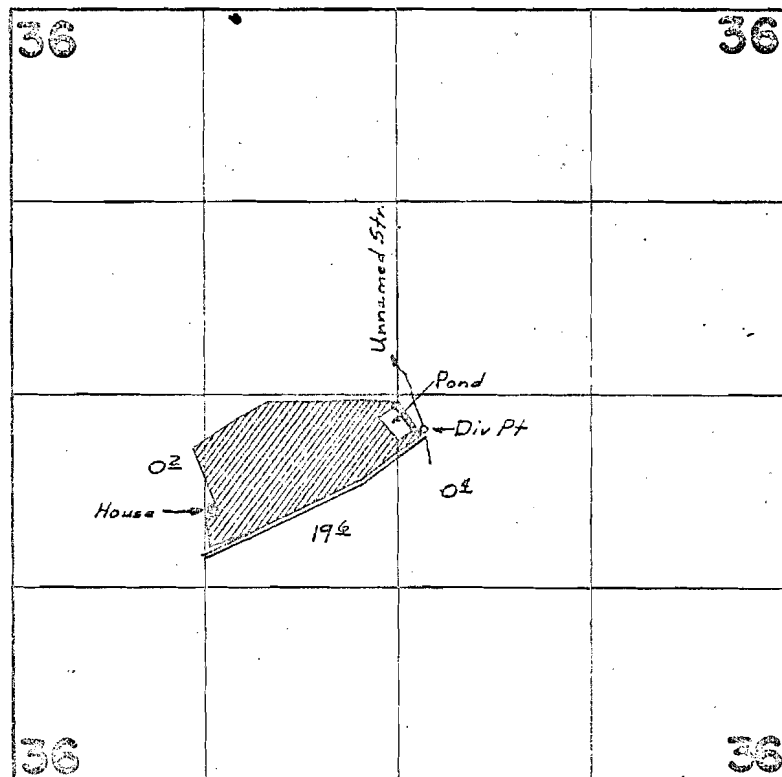

Div Pt located 240 ft S and 170 ft E from Center 1/4 Cor Sec 36

FINAL PROOF SURVEY
UNDER

R-39429 R-3947
Application No. 39430 Permit No. 29381
IN NAME OF

Ford and Vivian C. Wilke

Surveyed Aug. 12, 1967, by W. D. Ruppert