


T.18S.R.46E.W.M.

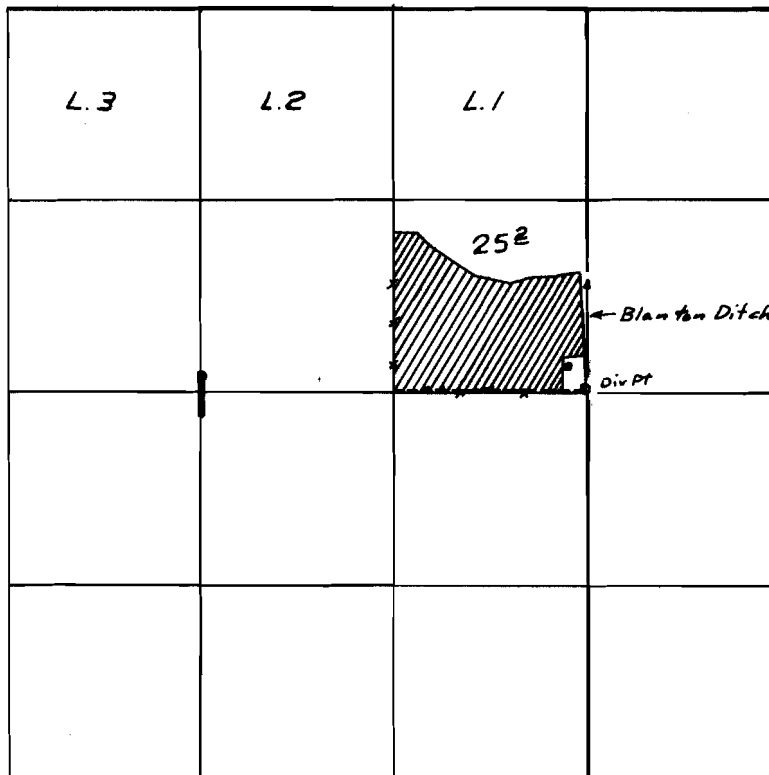

Div Pt located 20' N + 1310' E from SW Cor. SE 1/4 NE 1/4 Sec 1

FINAL PROOF SURVEY UNDER

Application No. 42136... Permit No. 31512...
IN NAME OF

.....Darrell Cochran.....

Surveyed Oct. 25, 1967, by W. U. Ruppert...