


T.9S.R.3E.W.M.

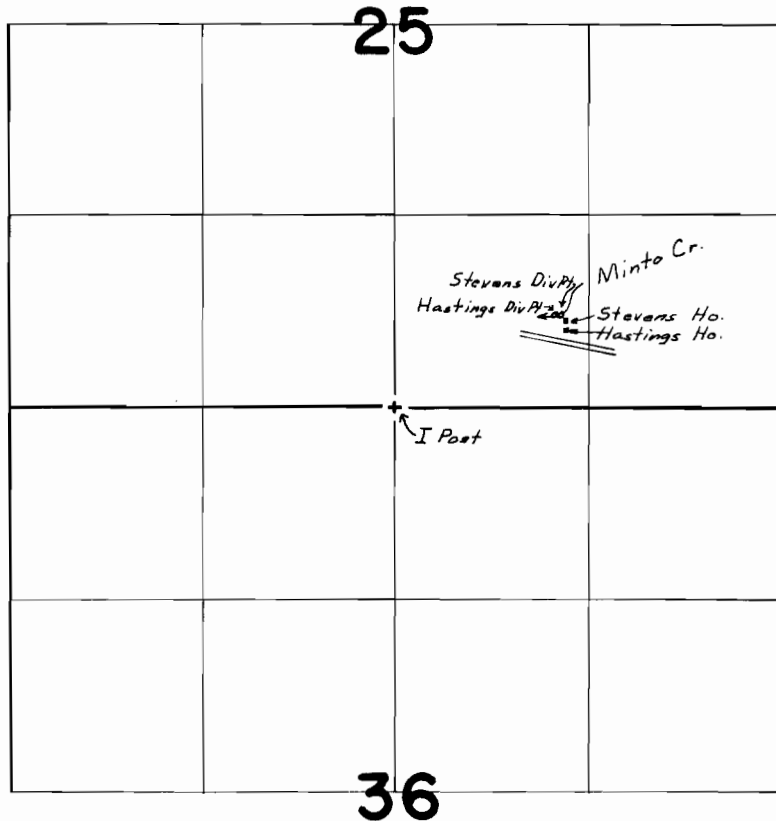

Stevens Div Pt located 630ft N & 1140ft E from S $\frac{1}{4}$ Cor Sec 25
Hastings Div Pt located 630ft N & 1090ft E from S $\frac{1}{4}$ Cor Sec 25

FINAL PROOF SURVEY UNDER

Application No. 42555 Permit No. 31519
IN NAME OF

Guy Hastings and Phillip Stevens

Surveyed Aug 11, 1967, by W.J. Ruppert