


T. 4 S. R. 16 E. W. M.

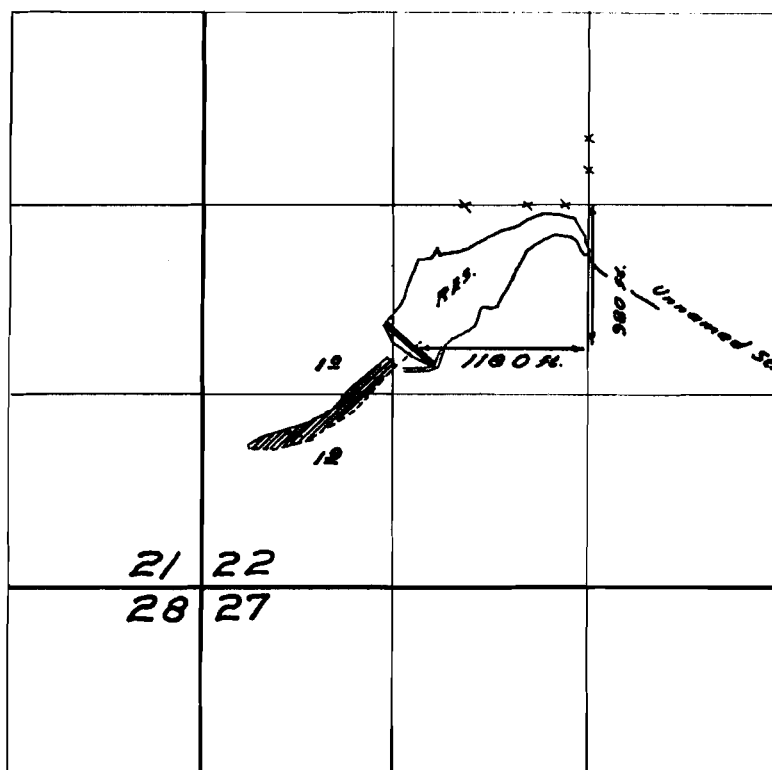

FINAL PROOF SURVEY UNDER

Application No. R-34738 34739 Permit No. R-2594 27276
IN NAME OF

Joe Bibby

Surveyed June 22 1966 by M. V. Ruppert