


T.3S.R.40E.W.M.

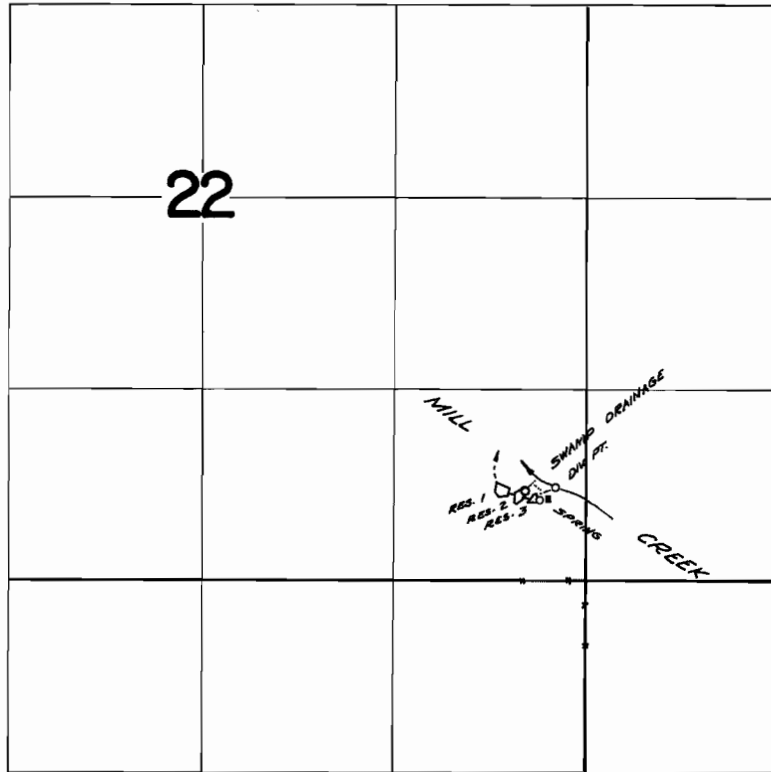

Div. Pts. located:- creek, 630 ft. N. & 210 ft. W., Spring, 550 ft. N. & 320 ft. W., drainage, 620 ft. N. & 420 ft. W., all from the S.E. cor. of section 22.

FINAL PROOF SURVEY UNDER

R-40901 *R-4597*
Application No. *40988* Permit No. *30563*
IN NAME OF

LOREN W. and ETHEL J. HUNT

Surveyed *Aug. 30, 1967*, by *V. Gardner*