


T.3S.R.40E.W.M.

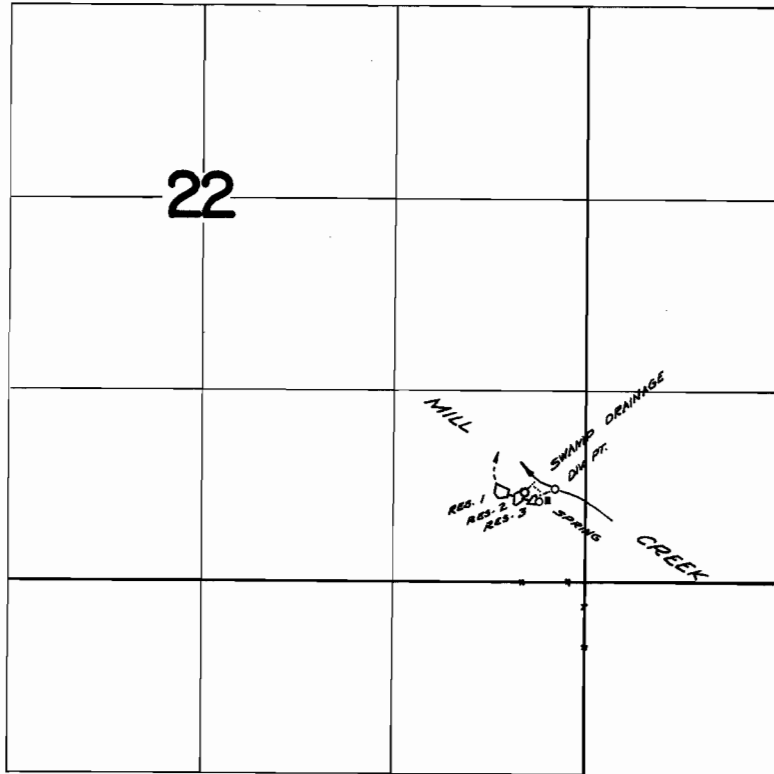

Div. Pts. located:- creek, 630 ft. N. & 210 ft. W.; Spring, 550 ft. N. & 320 ft. W.; drainage, 620 ft. N. & 420 ft. W., all from the S.E. cor. of section 22.

FINAL PROOF SURVEY UNDER

R 40901 R-4597
Application No. 40958 Permit No. 30563
IN NAME OF

LOREN W. and ETHEL J. HUNT

Surveyed Aug. 30, 1967, by V. Gardner