


T.2S.R.2W.W.M.

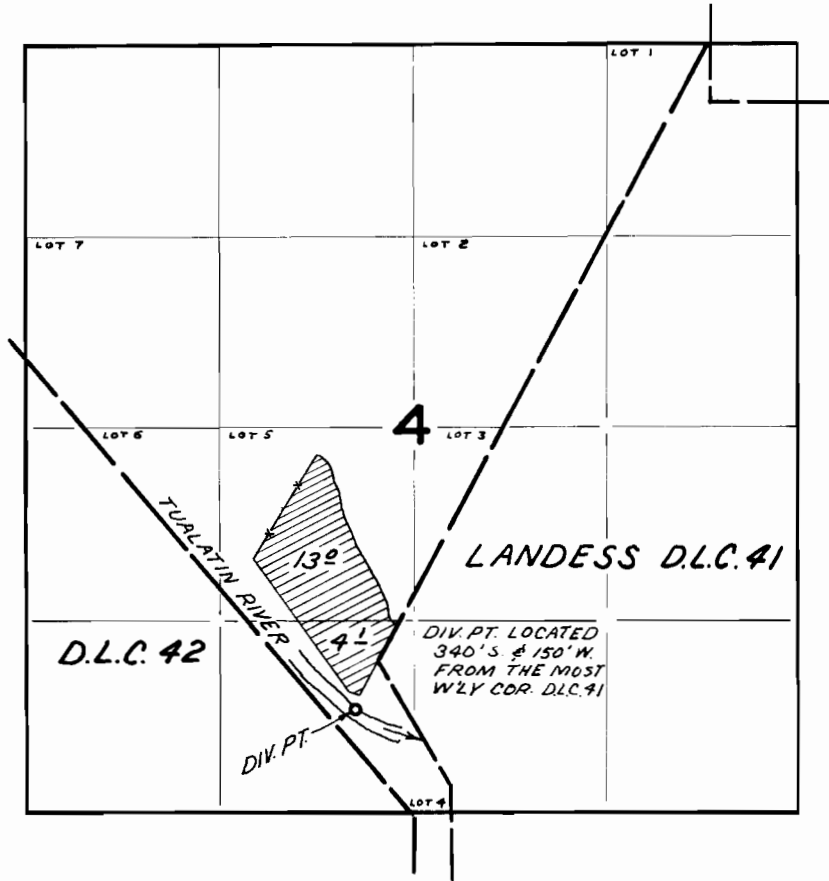

FINAL PROOF SURVEY
UNDER

Application No. 36797 Permit No. 27511
IN NAME OF

MARVIN W. AND PRISCILLA DECKER

Surveyed SEP 12 1967, by V. GARNER