


T.2S.R.2W. W.M.

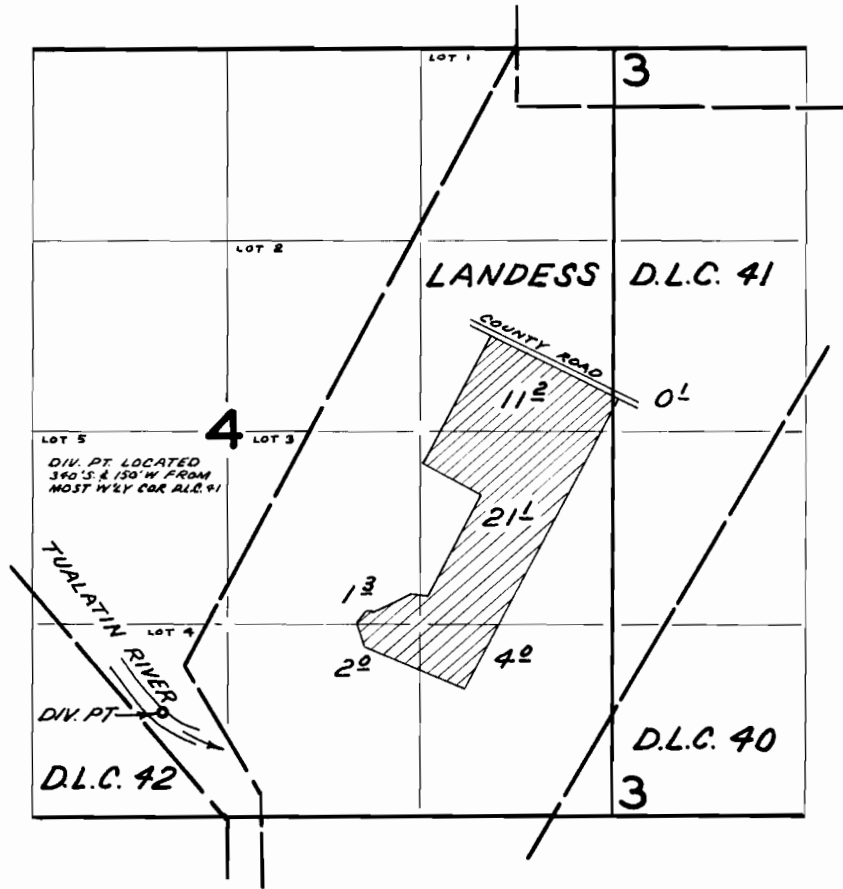

FINAL PROOF SURVEY UNDER

Application No. 37806 Permit No. 28278
IN NAME OF

MARVIN W. DECKER

Surveyed SEP 12 1967 by V. GARNER