


T.3N.R.4W.W.M.

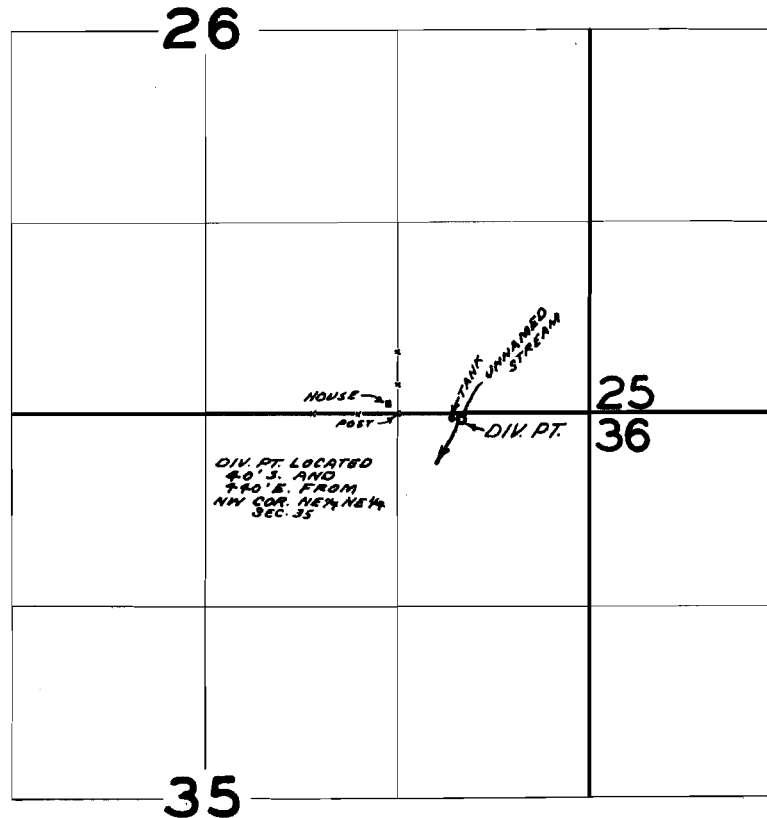

FINAL PROOF SURVEY
UNDER

Application No. 40735 Permit No. 30379
IN NAME OF

GAROLD E. TALLEY

Surveyed MAY 10 1967, by V. GARNER