


T.4S.R.4W.W.M.

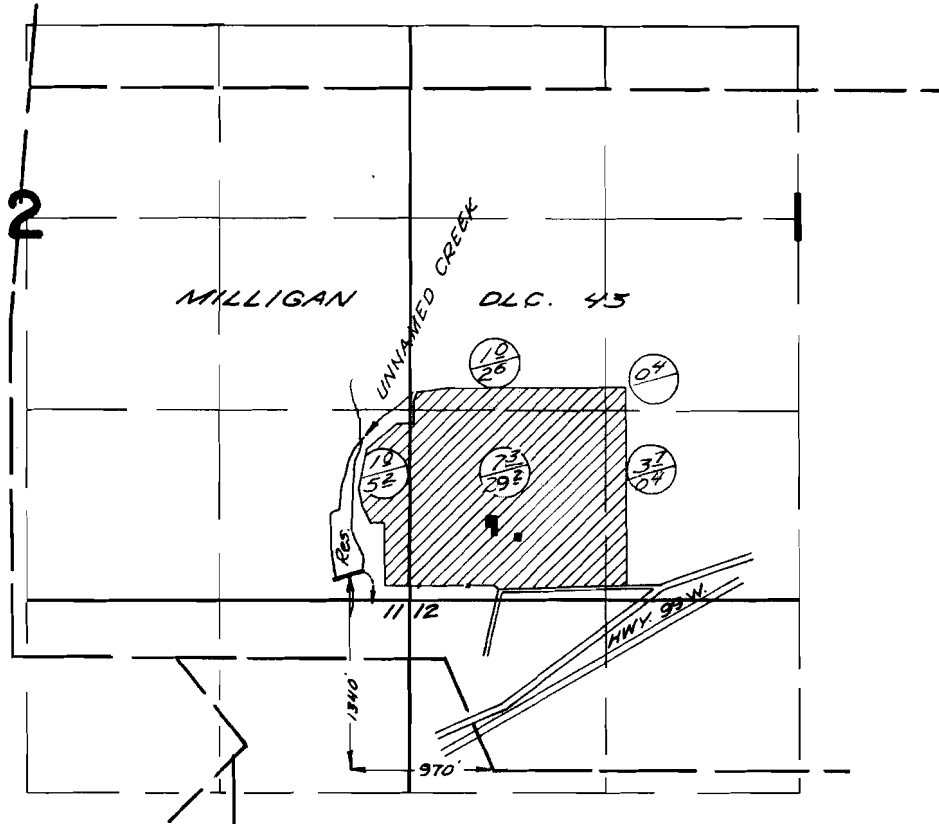

⊙ primary
⊕ supplemental

FINAL PROOF SURVEY UNDER

R-37450 R-2988
Application No. 37451 Permit No. 28105
IN NAME OF

L. F. BOURLAND

Surveyed Mar. 31, 1967, by J. Garner