


T.4S.R.4W.W.M.

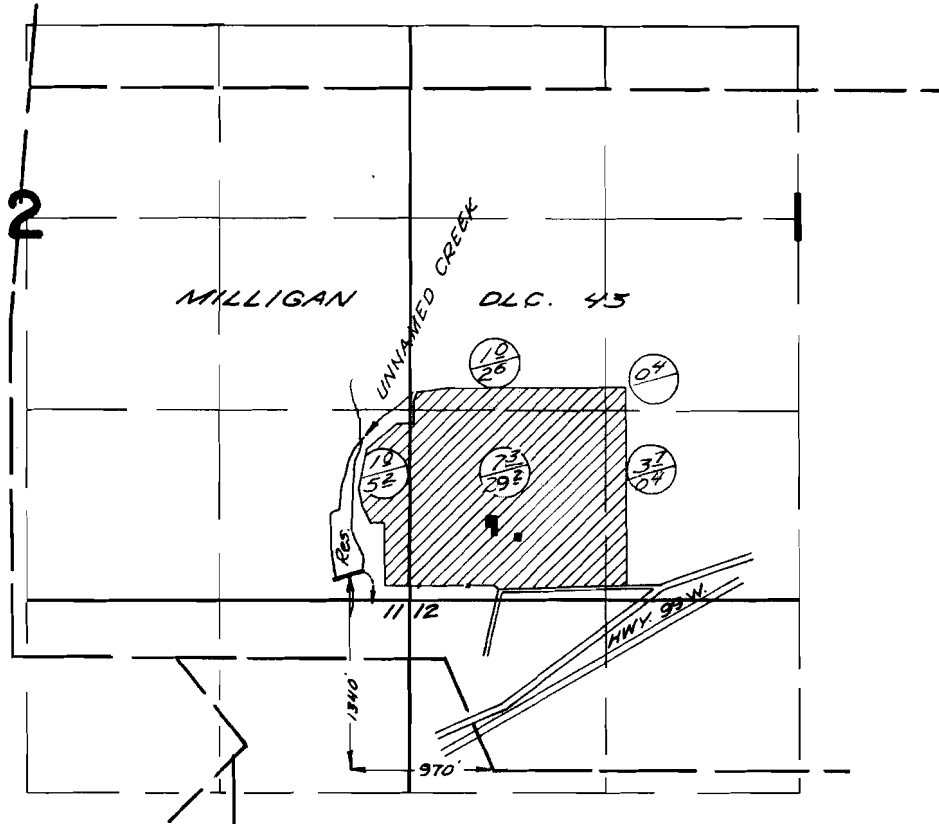

⊕ primary
⊙ supplemental

FINAL PROOF SURVEY
UNDER

R-37450 R-2988
Application No. 37451 Permit No. 28105
IN NAME OF

L. F. BOURLAND

Surveyed Mar. 31 1967, by J. Garner